

PROJECT:
WORKSHOP EL HISHIH
WADI – KHALED – AKKAR

Sheet Information

PROJECT NBR.

-

PROJECT PHASE

RE - TENDER

DISCIPLINE

CIVIL ENGINEERING

SECTOR

-

BUILDING

DESIGNED

GN

DRAWN

JOH

CHECKED

GN

APPROVED

07-2017

DATE

1/100, 1/20

SCALE

A2

SHEET SIZE

AS- BUILT DRAWING

LOCATION OF WORKS- GP PLAN

Sheet Title

Sheet nbr.

Phone

Discipline

Floor Area

Drawing Number


Revision

A - 1


REV	BY	APP	DESCRIPTION	DATE
1	GN	GN	REPAIRS FOR EXECUTION DEFLECTIONS	16-01-17

Revisions


THIS DRAWING IS A COPYRIGHT. DO NOT SCALE FROM THE DRAWING. THE CONTRACTOR AND HIS SUB-CONTRACTORS ARE TO VERIFY ALL DIMENSIONS ON SITE BEFORE MAKING SHOP DRAWINGS OR COMMENCING MANUFACTURE.



United Nation Development Programme




UNDP Lebanon




Social and Local Development Programme

Project No. 1152716 Beirut, Lebanon Tel: 961 1 962491

PROGRAMME:

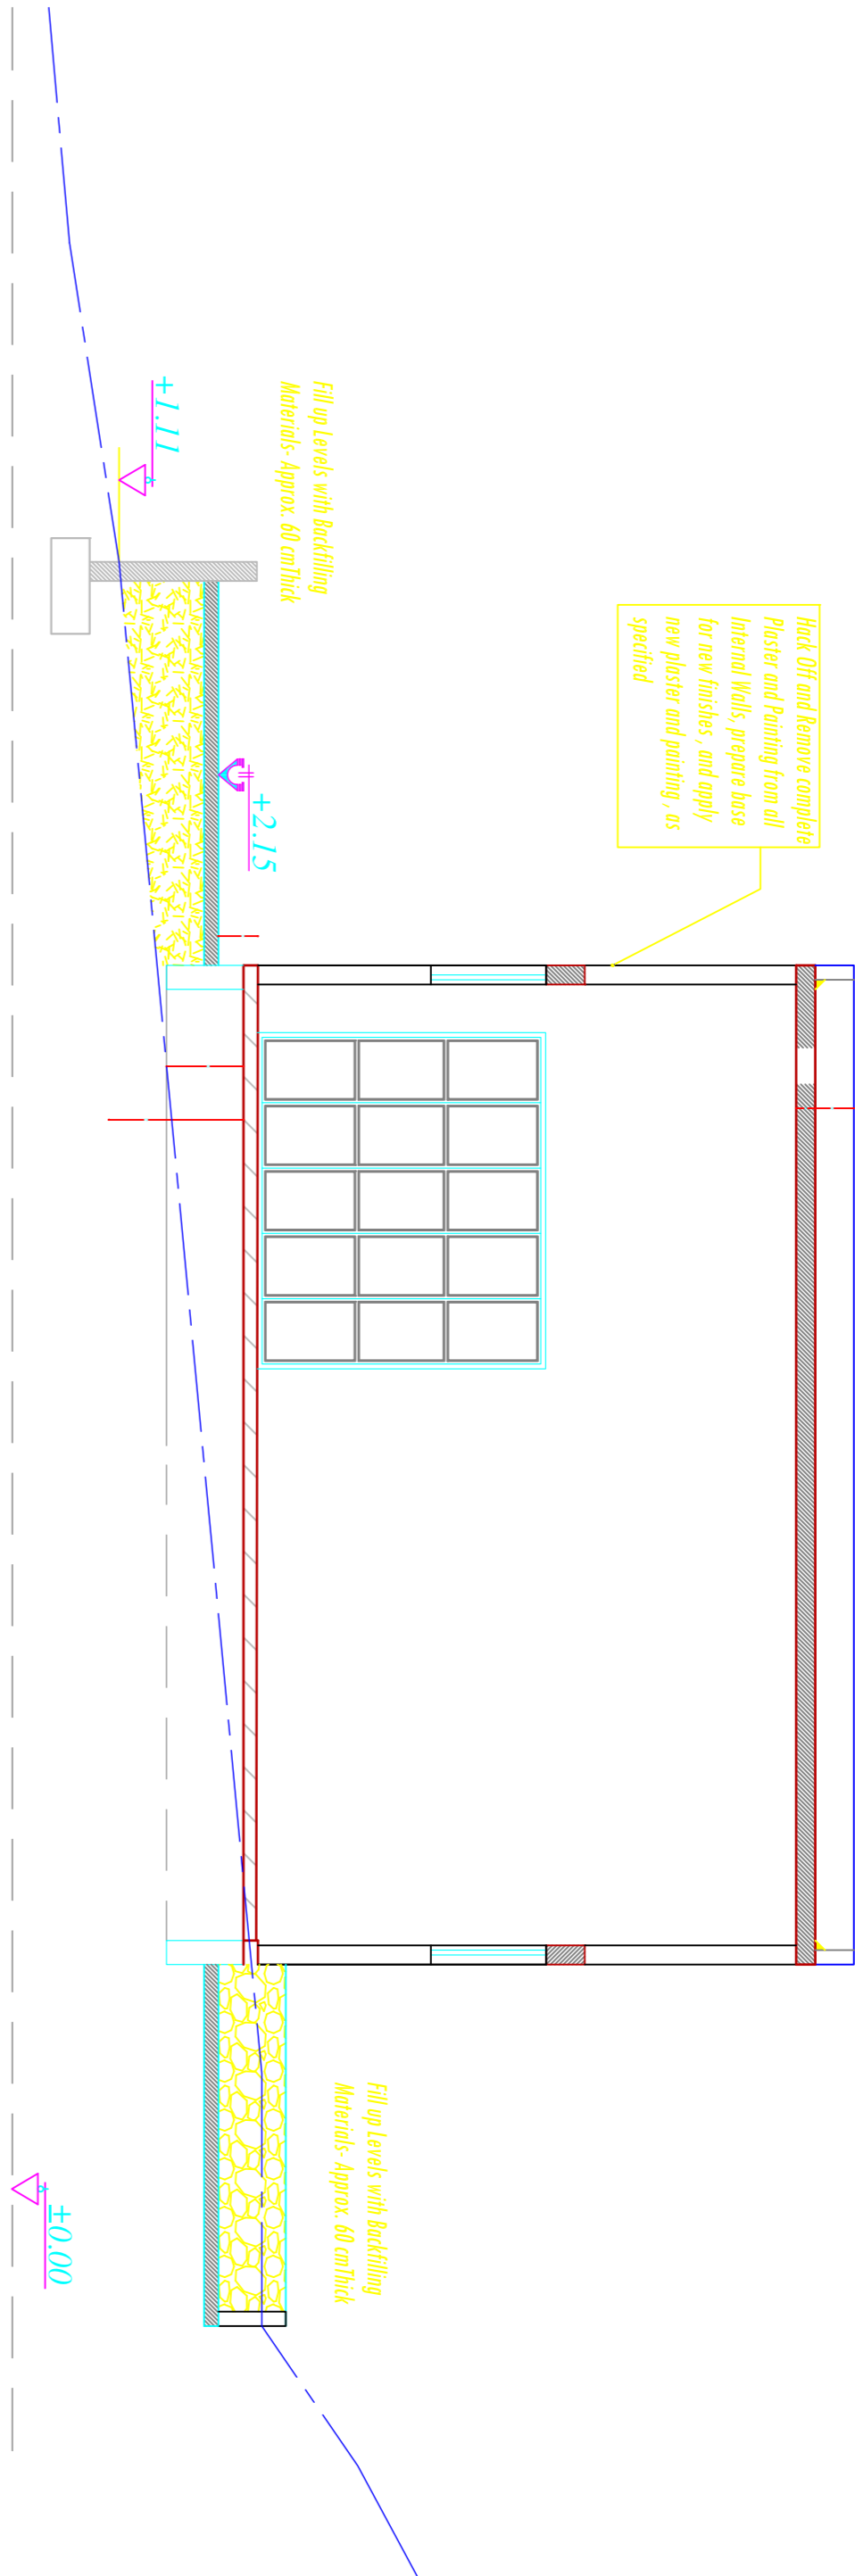

FRONT ELEVATION

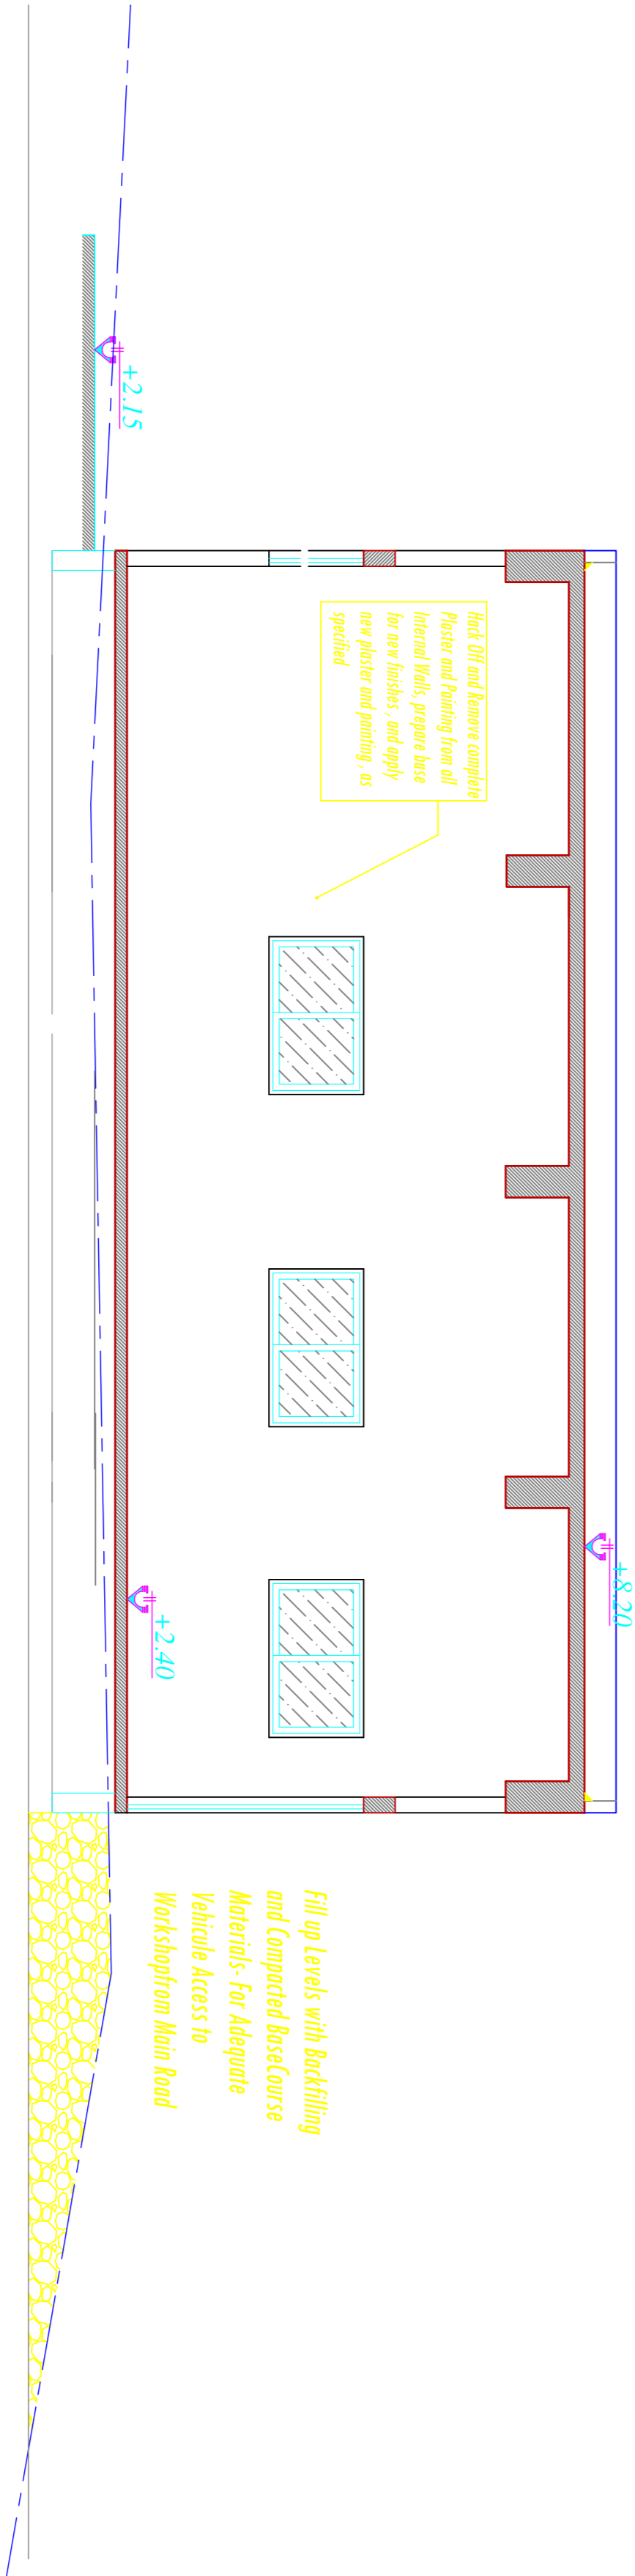


SIDE ELEVATION


REV	BY	APP	DESCRIPTION	DATE
1	GN	GN	REPAIRS FOR EXECUTION DEFLECTIONS	16-01-17

Revisions


THIS DRAWING IS A COPYRIGHT. DO NOT SCALE FROM THE DRAWING. DIMENSIONS ON SITE BEFORE MAKING SHOP DRAWINGS OR COMMENCING MANUFACTURE.



United Nation Development Programme

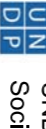

UNDP Lebanon
Social and Local Development Programme



Project: 1152716 Beirut, Lebanon (lat: 33° 1' 56.2481)

PROGRAMME:

PROJECT: *WORKSHOP EL HISHIH
WADI – KHALED – AKKAR*



Sheet Information

PROJECT NBR.	-	RE - TENDER
PROJECT PHASE	-	CIVIL ENGINEERING
DISCIPLINE	-	-
SECTOR	-	-
BUILDING	-	-
DESIGNED	GN	-
DRAWN	JR	-
CHECKED	GN	-
APPROVED	-	-
DATE	07-2017	-
SCALE	1/100, 1/20	-
SHEET SIZE	A2	-


Sheet Title

*AS-BUILT DRAWING
LOCATION OF WORKS- ELEVATIONS*

Sheet nbr.

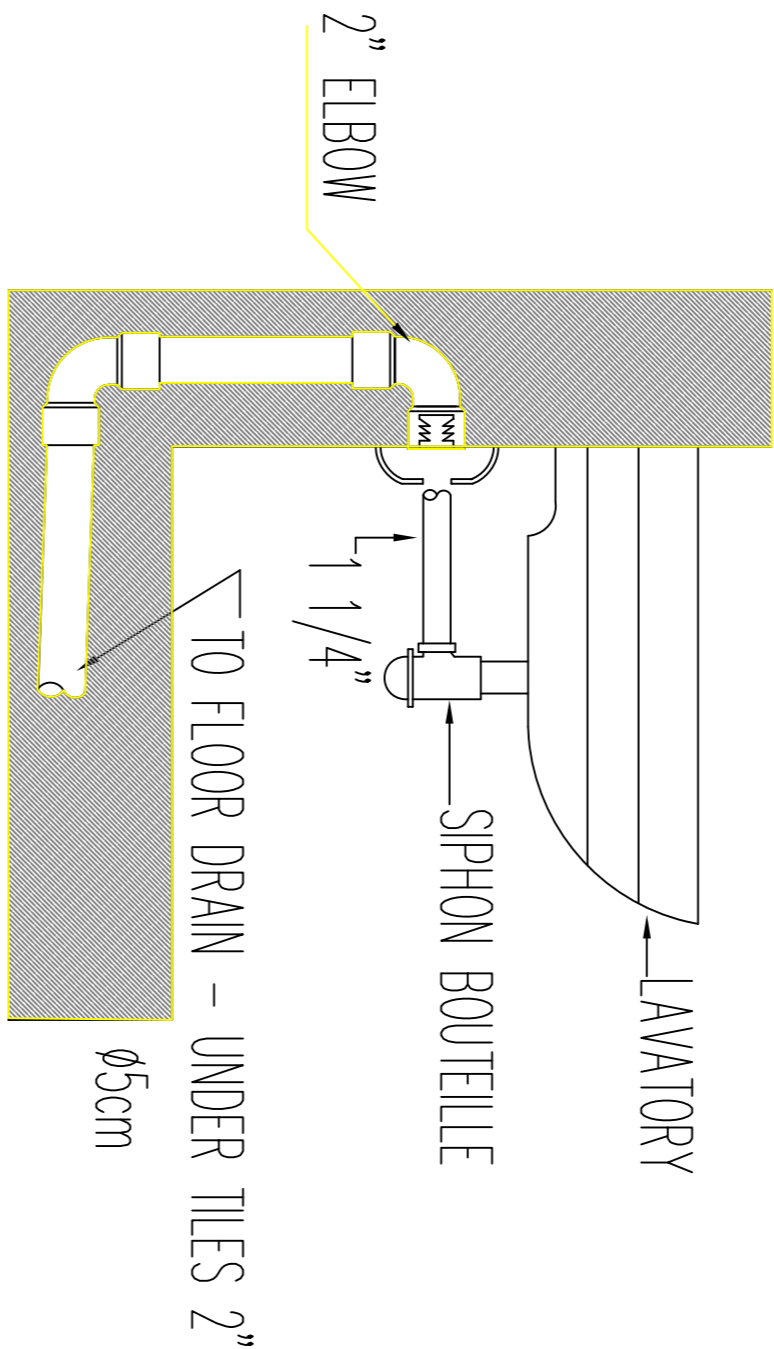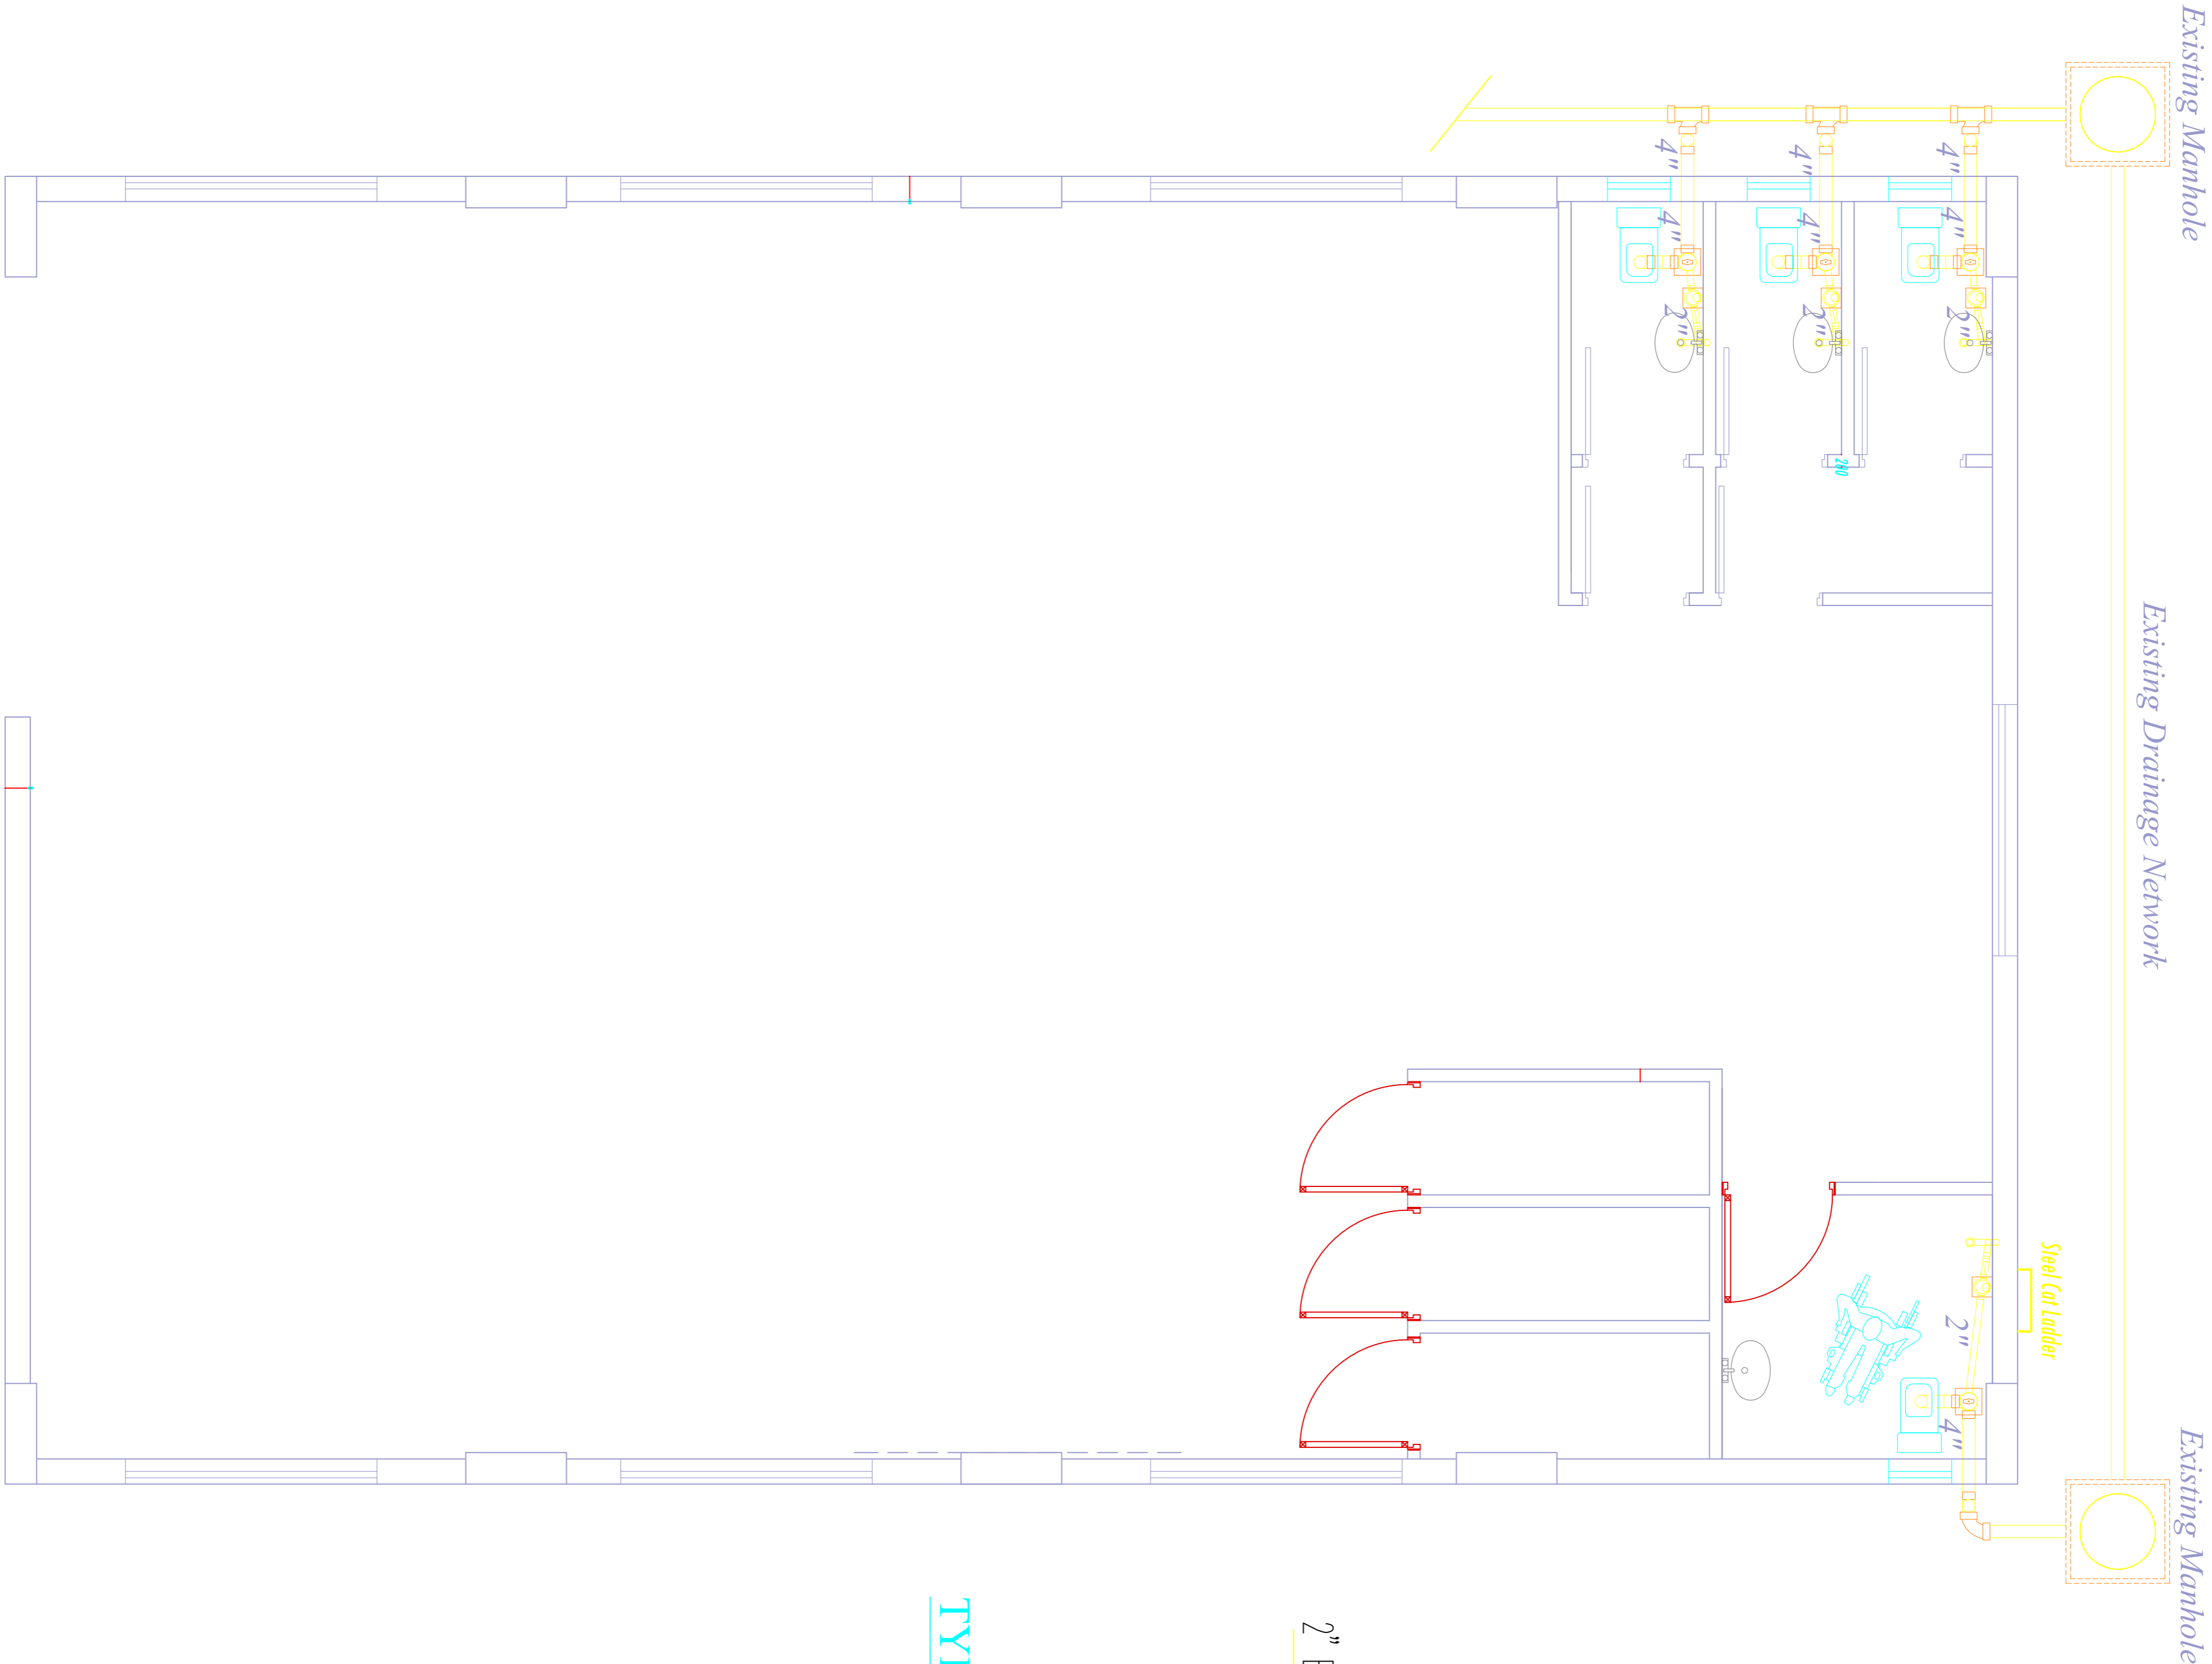

TYPICAL CONNEXION FOR LAVATORY

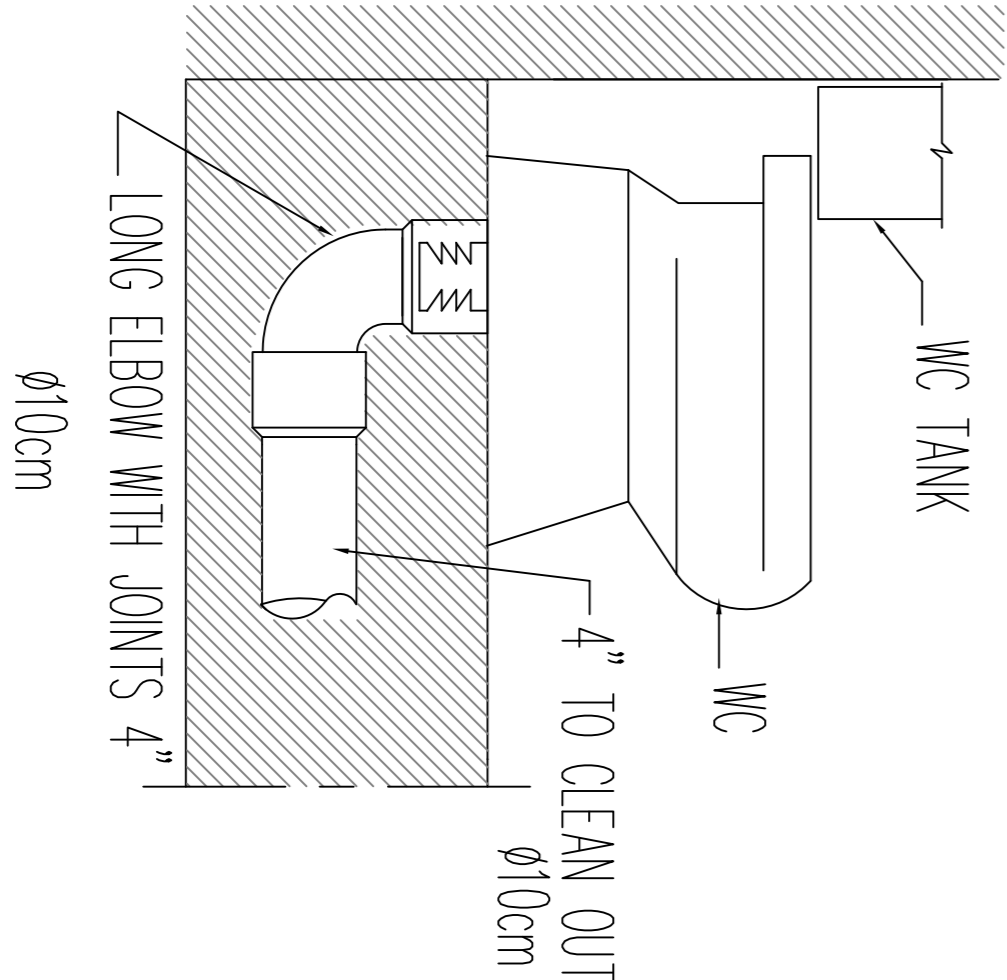



TYPICAL CONNEXION FO W.C

NOTES

REV	BY	APP	DESCRIPTION	DATE
1	GN	GN	REPAIRS FOR EXECUTION DEFLECTIONS	16-01-17

Revisions

THIS DRAWING IS A COPYRIGHT. DO NOT SCALE FROM THE DRAWING.
THE CONTRACTOR AND HIS SUB-CONTRACTORS ARE TO VERIFY ALL
DIMENSIONS ON SITE BEFORE MAKING SHOP DRAWINGS OR
COMMENCING MANUFACTURE.

	United Nation Development Programme
	UNDP Lebanon
	Social and Local Development Programme
	Pro-Bat, 115276 Beirut, Lebanon (tel: 961 1 962491)

PROGRAMME:

PROJECT: **WORKSHOP EL HISHIH**
WADI – KHALED – AKKAR

Sheet Information

PROJECT NBR.	-	RE - TENDER
PROJECT PHASE	-	CIVIL ENGINEERING
DISCIPLINE	-	-
SECTOR	-	-
BUILDING	-	-
DESIGNED	GN	-
DRAWN	JR	-
CHECKED	GN	-
APPROVED	-	-
DATE	07-2017	-
SCALE	1/100, 1/20	-
SHEET SIZE	A2	-



Sheet Title

MECHANICAL WORKS
DRAINAGE – DETAILS


Sheet nbr.

M - 1

Phase | Discipline | Floor Area | Drawing Number | Revision

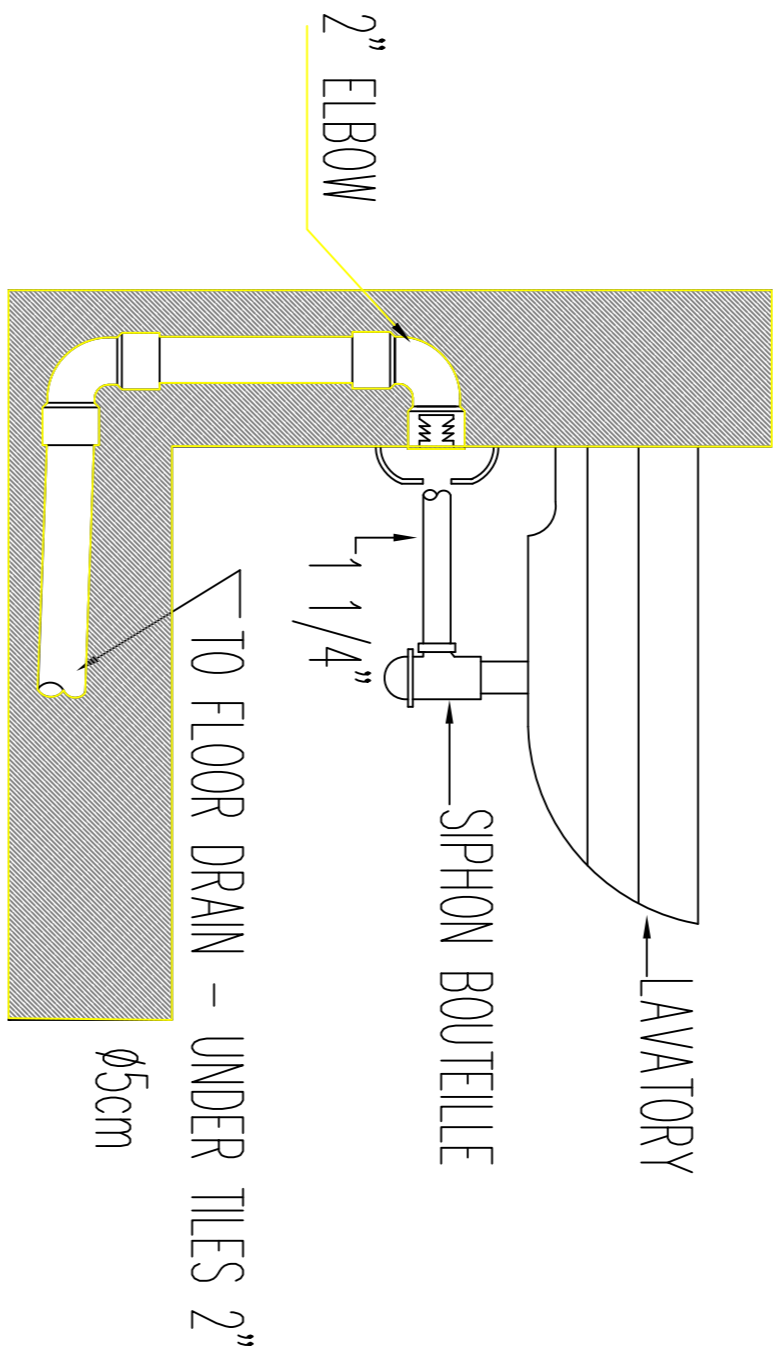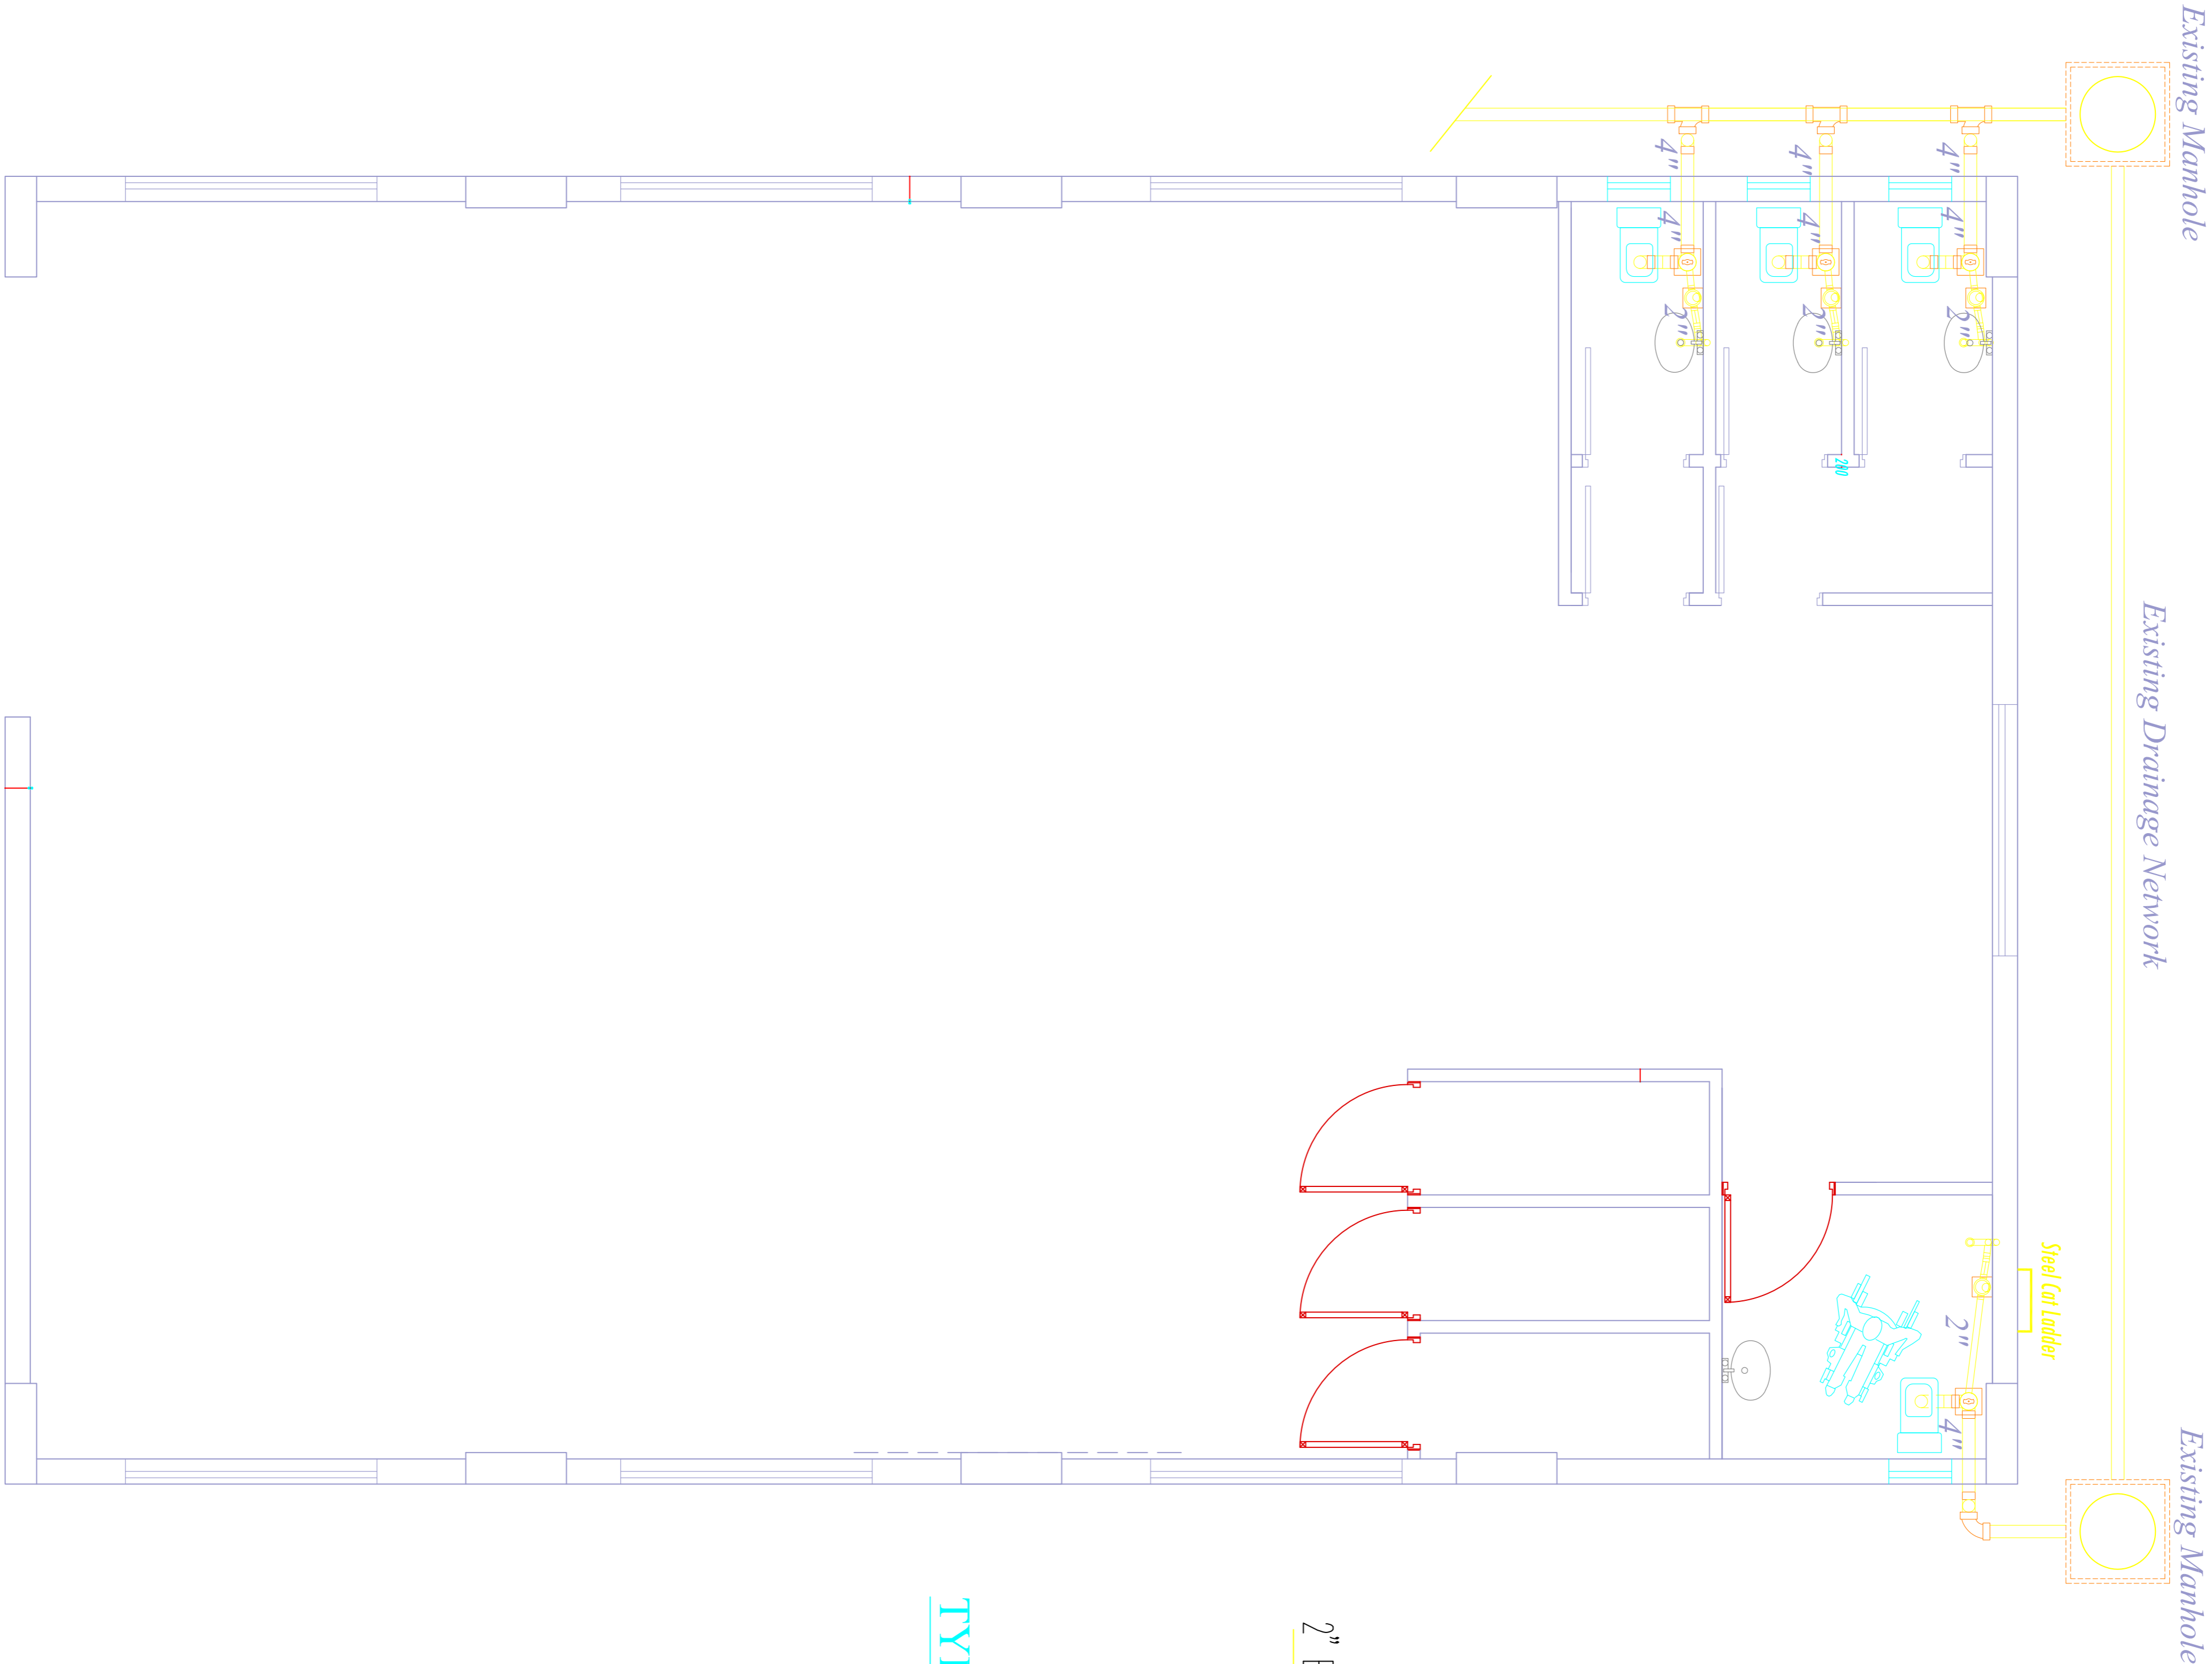

TYPICAL CONNEXION FOR LAVATORY

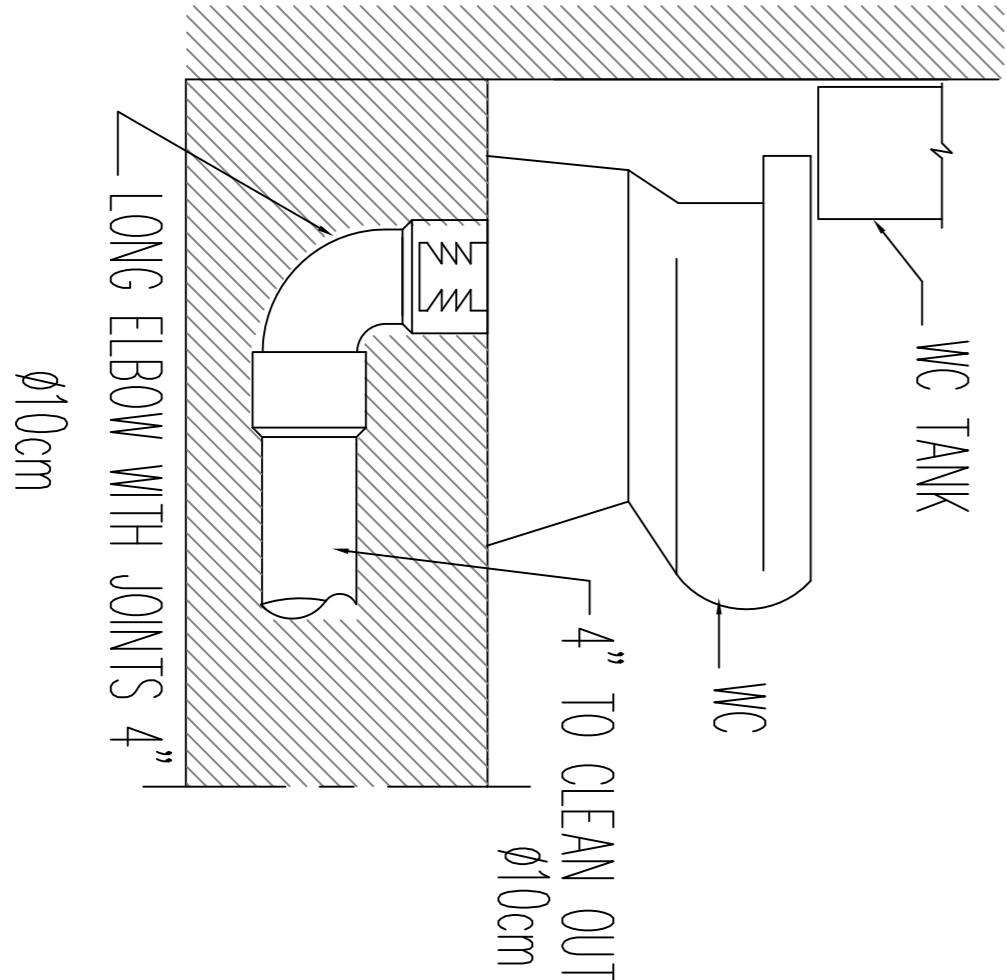


TYPICAL CONNEXION FO W.C

NOTES

REV	BY	APP	DESCRIPTION	DATE
1	GN	GN	REPAIRS FOR EXECUTION DEFLECTIONS	16-01-17

Revisions

THIS DRAWING IS A COPYRIGHT. DO NOT SCALE FROM THE DRAWING.
THE CONTRACTOR AND HIS SUB-CONTRACTORS ARE TO VERIFY ALL
DIMENSIONS ON SITE BEFORE MAKING SHOP DRAWINGS OR
COMMENCING MANUFACTURE.

	United Nation Development Programme
	UNDP Lebanon
	Social and Local Development Programme
	Pro-Bat, 115276 Beirut, Lebanon (tel: 961 1 962491)

PROGRAMME:

PROJECT: **WORKSHOP EL HISHIH**
WADI – KHALED – AKKAR

Sheet Information

PROJECT NBR.	-	RE - TENDER
PROJECT PHASE	-	CIVIL ENGINEERING
DISCIPLINE	-	-
SECTOR	-	-
BUILDING	-	-
DESIGNED	GN	-
DRAWN	JR	-
CHECKED	GN	-
APPROVED	-	-
DATE	07-2017	-
SCALE	1/100, 1/20	-
SHEET SIZE	A2	-


Sheet Title

MECHANICAL WORKS
DRAINAGE – DETAILS

Sheet nbr.

M - 1

Phase	Discipline	Floor Area	Drawing Number	Revision
-------	------------	------------	----------------	----------

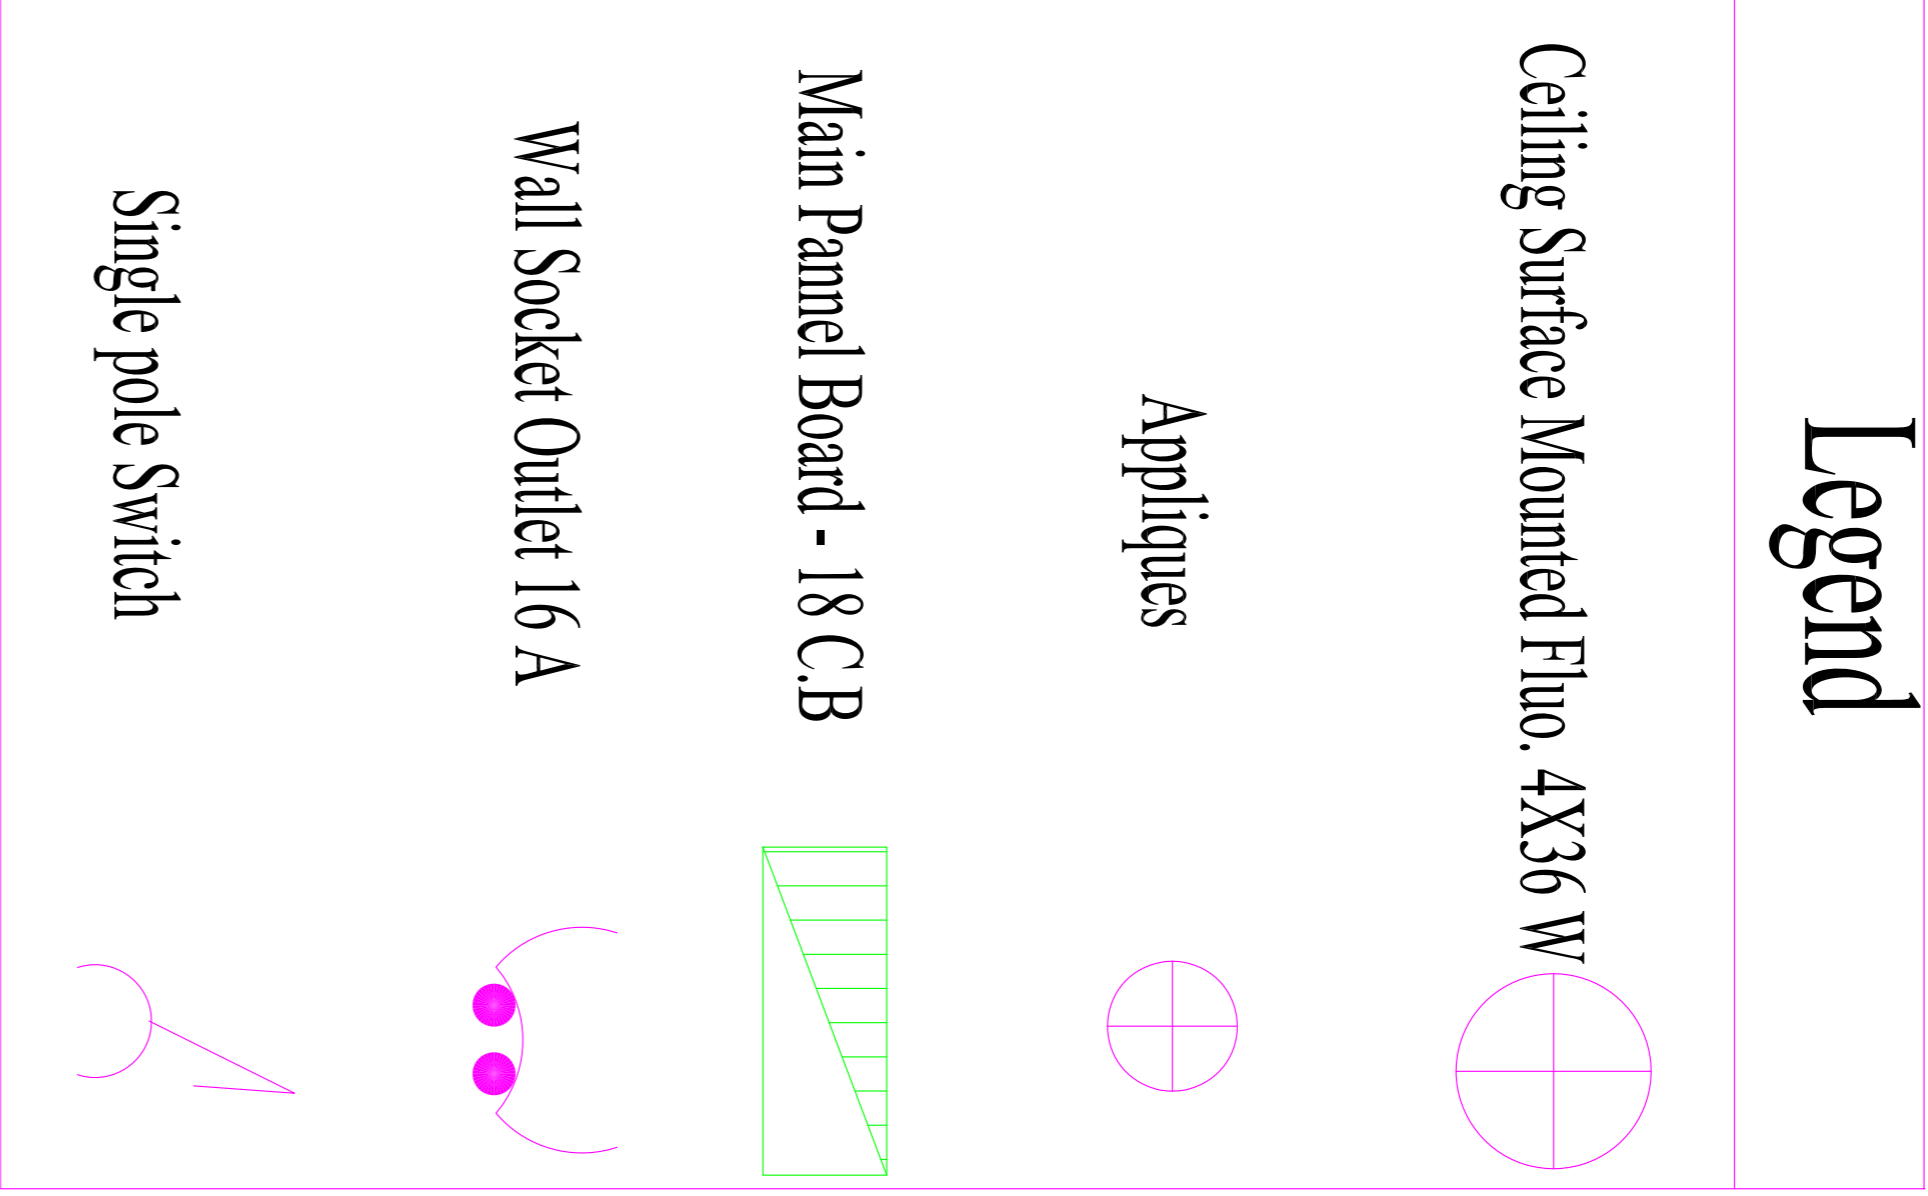

THIS DRAWING IS A COPYRIGHT. DO NOT SCALE FROM THE DRAWING. THE CONTRACTOR AND HIS SUB-CONTRACTORS ARE TO VERIFY ALL DIMENSIONS ON SITE BEFORE MAKING SHOP DRAWINGS OR COMMENCING MANUFACTURE.

PROGRAMME:

Sheet Title

ELECTRICAL WORKS

LIGHTING – POWER