

CUSTOMER : GREEN ONE UN HOUSE  
PROJECT : DOMESTIC WASTEWATER TREATMENT PLANT  
JOB No. :  
PLANT : DOMESTIC WASTEWATER TREATMENT PLANT

MECHANICAL DRAWING

AS-BUILT DRAWING

16-Nov-2017



**GOSHU KOHSAN (VIETNAM) CO.,LTD.**

HANOI HEAD OFFICE  
LOT P1, THANG LONG IP, DONG ANH DIST,  
HANOI, VIETNAM.  
<http://www.goshukohsan.com.vn>

| DRAWING LIST |              |                                          |        |
|--------------|--------------|------------------------------------------|--------|
| ITEM         | DRAWING No.  | DRAWING TITLE                            | REMARK |
| 1            | DWWTP-ME-001 | FLOW SHEET                               |        |
| 2            | DWWTP-ME-101 | LAYOUT                                   |        |
| 3            | DWWTP-ME-102 | GENERAL LAYOUT                           |        |
| 4            | DWWTP-ME-103 | OVER ALL LAYOUT                          |        |
| 5            | DWWTP-ME-104 | SLEEVE LAYOUT                            |        |
| 6            | DWWTP-ME-200 | EQUIPMENT LAYOUT                         |        |
| 7            | DWWTP-ME-201 | PIPING LAYOUT                            |        |
| 8            | DWWTP-ME-301 | RAW WW PUMP & SLUDGE RETURN PUMP         |        |
| 9            | DWWTP-ME-302 | MBR FILTERED PUMP                        |        |
| 10           | DWWTP-ME-303 | BLOWER DETAIL                            |        |
| 11           | DWWTP-ME-304 | MBR CLEANING PUMP                        |        |
| 12           | DWWTP-ME-305 | AIR PIPE EQUALIZATION TANK & SLUDGE TANK |        |
| 13           | DWWTP-ME-306 | AIR PIPE NITRIFICATION TANK              |        |
| 14           | DWWTP-ME-401 | MANUAL FINE SCREEN                       |        |
| 15           | DWWTP-ME-402 | BASKET DETAIL                            |        |
| 16           | DWWTP-ME-403 | BASKET INSTALLATION                      |        |
| 17           | DWWTP-ME-404 | CHLORINATOR BOX                          |        |
| 18           | DWWTP-ME-405 | PVC TRAY                                 |        |
|              |              |                                          |        |

AS BUILT DRAWING




16-Nov-2017

GOSHU KOHSAN (VIET NAM) CO.,LTD.  
PLANT DEPARTMENT

|                 |      |       |         |            |                                   |                                                          |                                                                                                                                                                                                                                                                                            |                      |                           |                                              |                           |
|-----------------|------|-------|---------|------------|-----------------------------------|----------------------------------------------------------|--------------------------------------------------------------------------------------------------------------------------------------------------------------------------------------------------------------------------------------------------------------------------------------------|----------------------|---------------------------|----------------------------------------------|---------------------------|
| Revision Record |      |       |         |            | Messrs.<br><br>GREEN ONE UN HOUSE | Project Name.<br><br>DOMESTIC WASTEWATER TREATMENT PLANT |  <b>GOSHU KOHSAN (VIETNAM) CO.,LTD.</b><br>HANOI HEAD OFFICE<br>LOT P1, THANG LONG IP, DONG ANH DIST,<br>HANOI, VIETNAM.<br><a href="http://www.goshukohsan.com.vn">http://www.goshukohsan.com.vn</a> | Designer<br>D.G.LONG | Dwg. Date<br>30/08/2017   | Item.<br>DOMESTIC WASTEWATER TREATMENT PLANT | Rev. No.<br>00            |
|                 |      |       |         |            |                                   |                                                          |                                                                                                                                                                                                                                                                                            | Check.<br>T.X.THANH  | Issued Date<br>16/11/2017 | Dwg. Title.<br>DRAWING LIST                  | Scale<br>NONE             |
|                 |      |       |         |            |                                   |                                                          |                                                                                                                                                                                                                                                                                            | Approved.<br>N.VY    | Drawn By.<br>C.V.HOA      | Job No.<br>-                                 | Dwg. Code<br>DWWTP-ME-000 |
|                 | Rev. | Date. | Content | Request BY |                                   |                                                          |                                                                                                                                                                                                                                                                                            |                      |                           |                                              |                           |

## AS BUILT DRAWING

16-Nov-2017

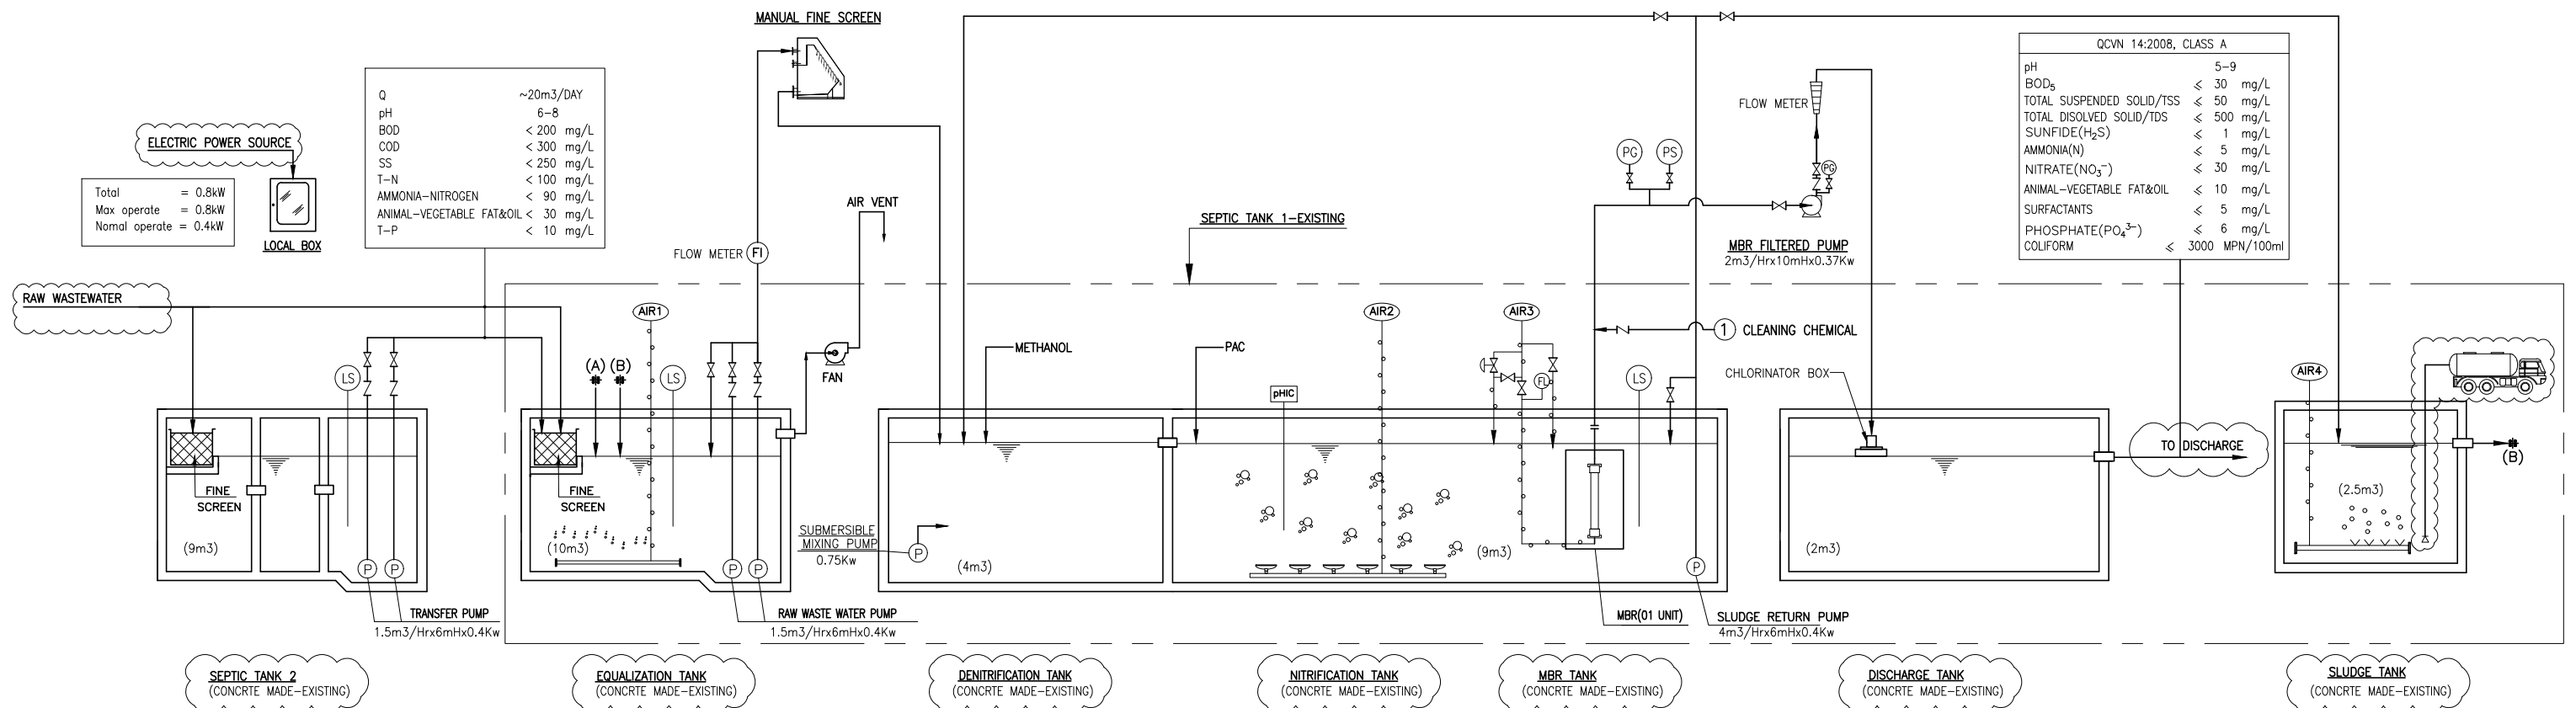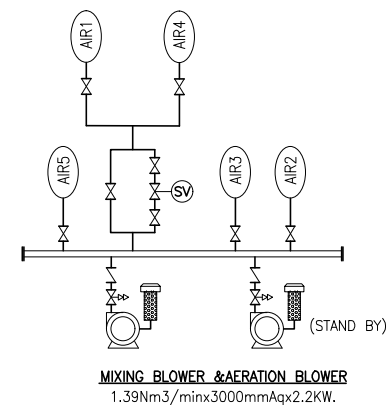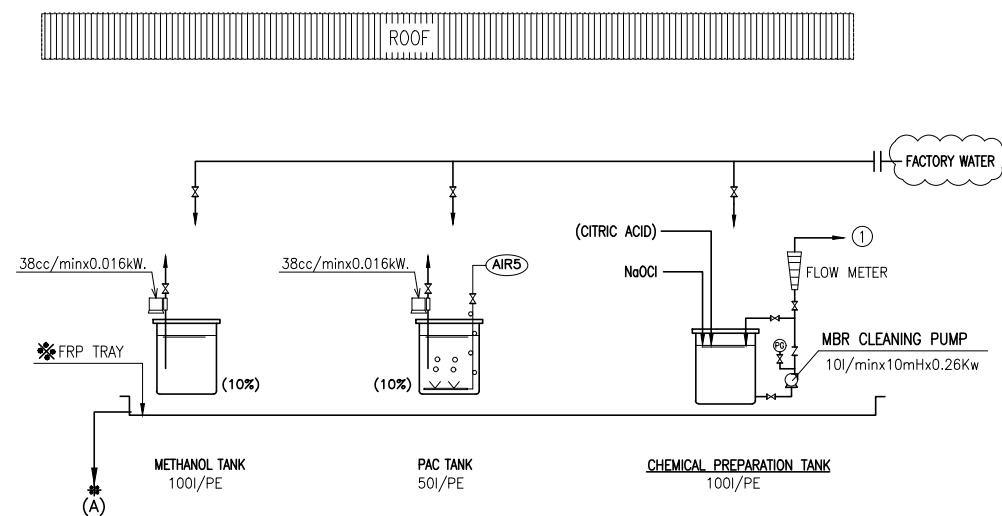GOSHU KOHSAN(VIETNAM)CO.,LTD.  
PLANT DEPARTMENT

## REMARKS


= BY OTHER

ELECTRIC POWER SOURCE  
220/380VAC, 50HZ, 3φ, 4W+1E

TOTAL = 8KW

|                 |      |            |                                                    |            |                                   |                                                           |                                                                                                                                                                                                                                                                                               |           |           |             |            |             |                                      |              |          |     |
|-----------------|------|------------|----------------------------------------------------|------------|-----------------------------------|-----------------------------------------------------------|-----------------------------------------------------------------------------------------------------------------------------------------------------------------------------------------------------------------------------------------------------------------------------------------------|-----------|-----------|-------------|------------|-------------|--------------------------------------|--------------|----------|-----|
| Revision Record | 3    | 16/11/2017 | AS-BUILT DRAWING                                   |            | Messrs.<br><br>GREEN ONE UN HOUSE | Project Name.<br><br>DOMESTIC WASTE WATER TREATMENT PLANT | <br><b>GOSHU KOHSAN (VIETNAM) CO.,LTD.</b><br>HANOI HEAD OFFICE<br>LOT P1, THANG LONG IP, DONG ANH DIST,<br>HANOI, VIETNAM.<br><a href="http://www.goshukohsan.com.vn">http://www.goshukohsan.com.vn</a> | Designer  | D.G.LONG  | Dwg. Date   | 07/12/2016 | Item.       | DOMESTIC WASTE WATER TREATMENT PLANT |              | Rev. No. | 3.0 |
|                 | 2    | 20/6/2017  | Remove NaOH tank, 1pcs MBR filtered pump           | Sales      |                                   |                                                           |                                                                                                                                                                                                                                                                                               | Check.    | T.X.THANH | Issued Date | 16/11/2017 | Dwg. Title. | FLOW SHEET                           |              | Scale    | N/A |
|                 | 1    | 12/4/2017  | Change capacity of blower: 1.1Nm3/min->1.39Nm3/min | Sales      |                                   |                                                           |                                                                                                                                                                                                                                                                                               | Approved. | NG.VY     | Drawn By.   | C.V.HOA    | Job No.     | Dwg. Code                            | DWWTP-ME-001 |          |     |
|                 | 00   | 07/12/2016 | First issue                                        | Sales      |                                   |                                                           |                                                                                                                                                                                                                                                                                               |           |           |             |            |             |                                      |              |          |     |
|                 | Rev. | Date.      | Content                                            | Request by |                                   |                                                           |                                                                                                                                                                                                                                                                                               |           |           |             |            |             |                                      |              |          |     |



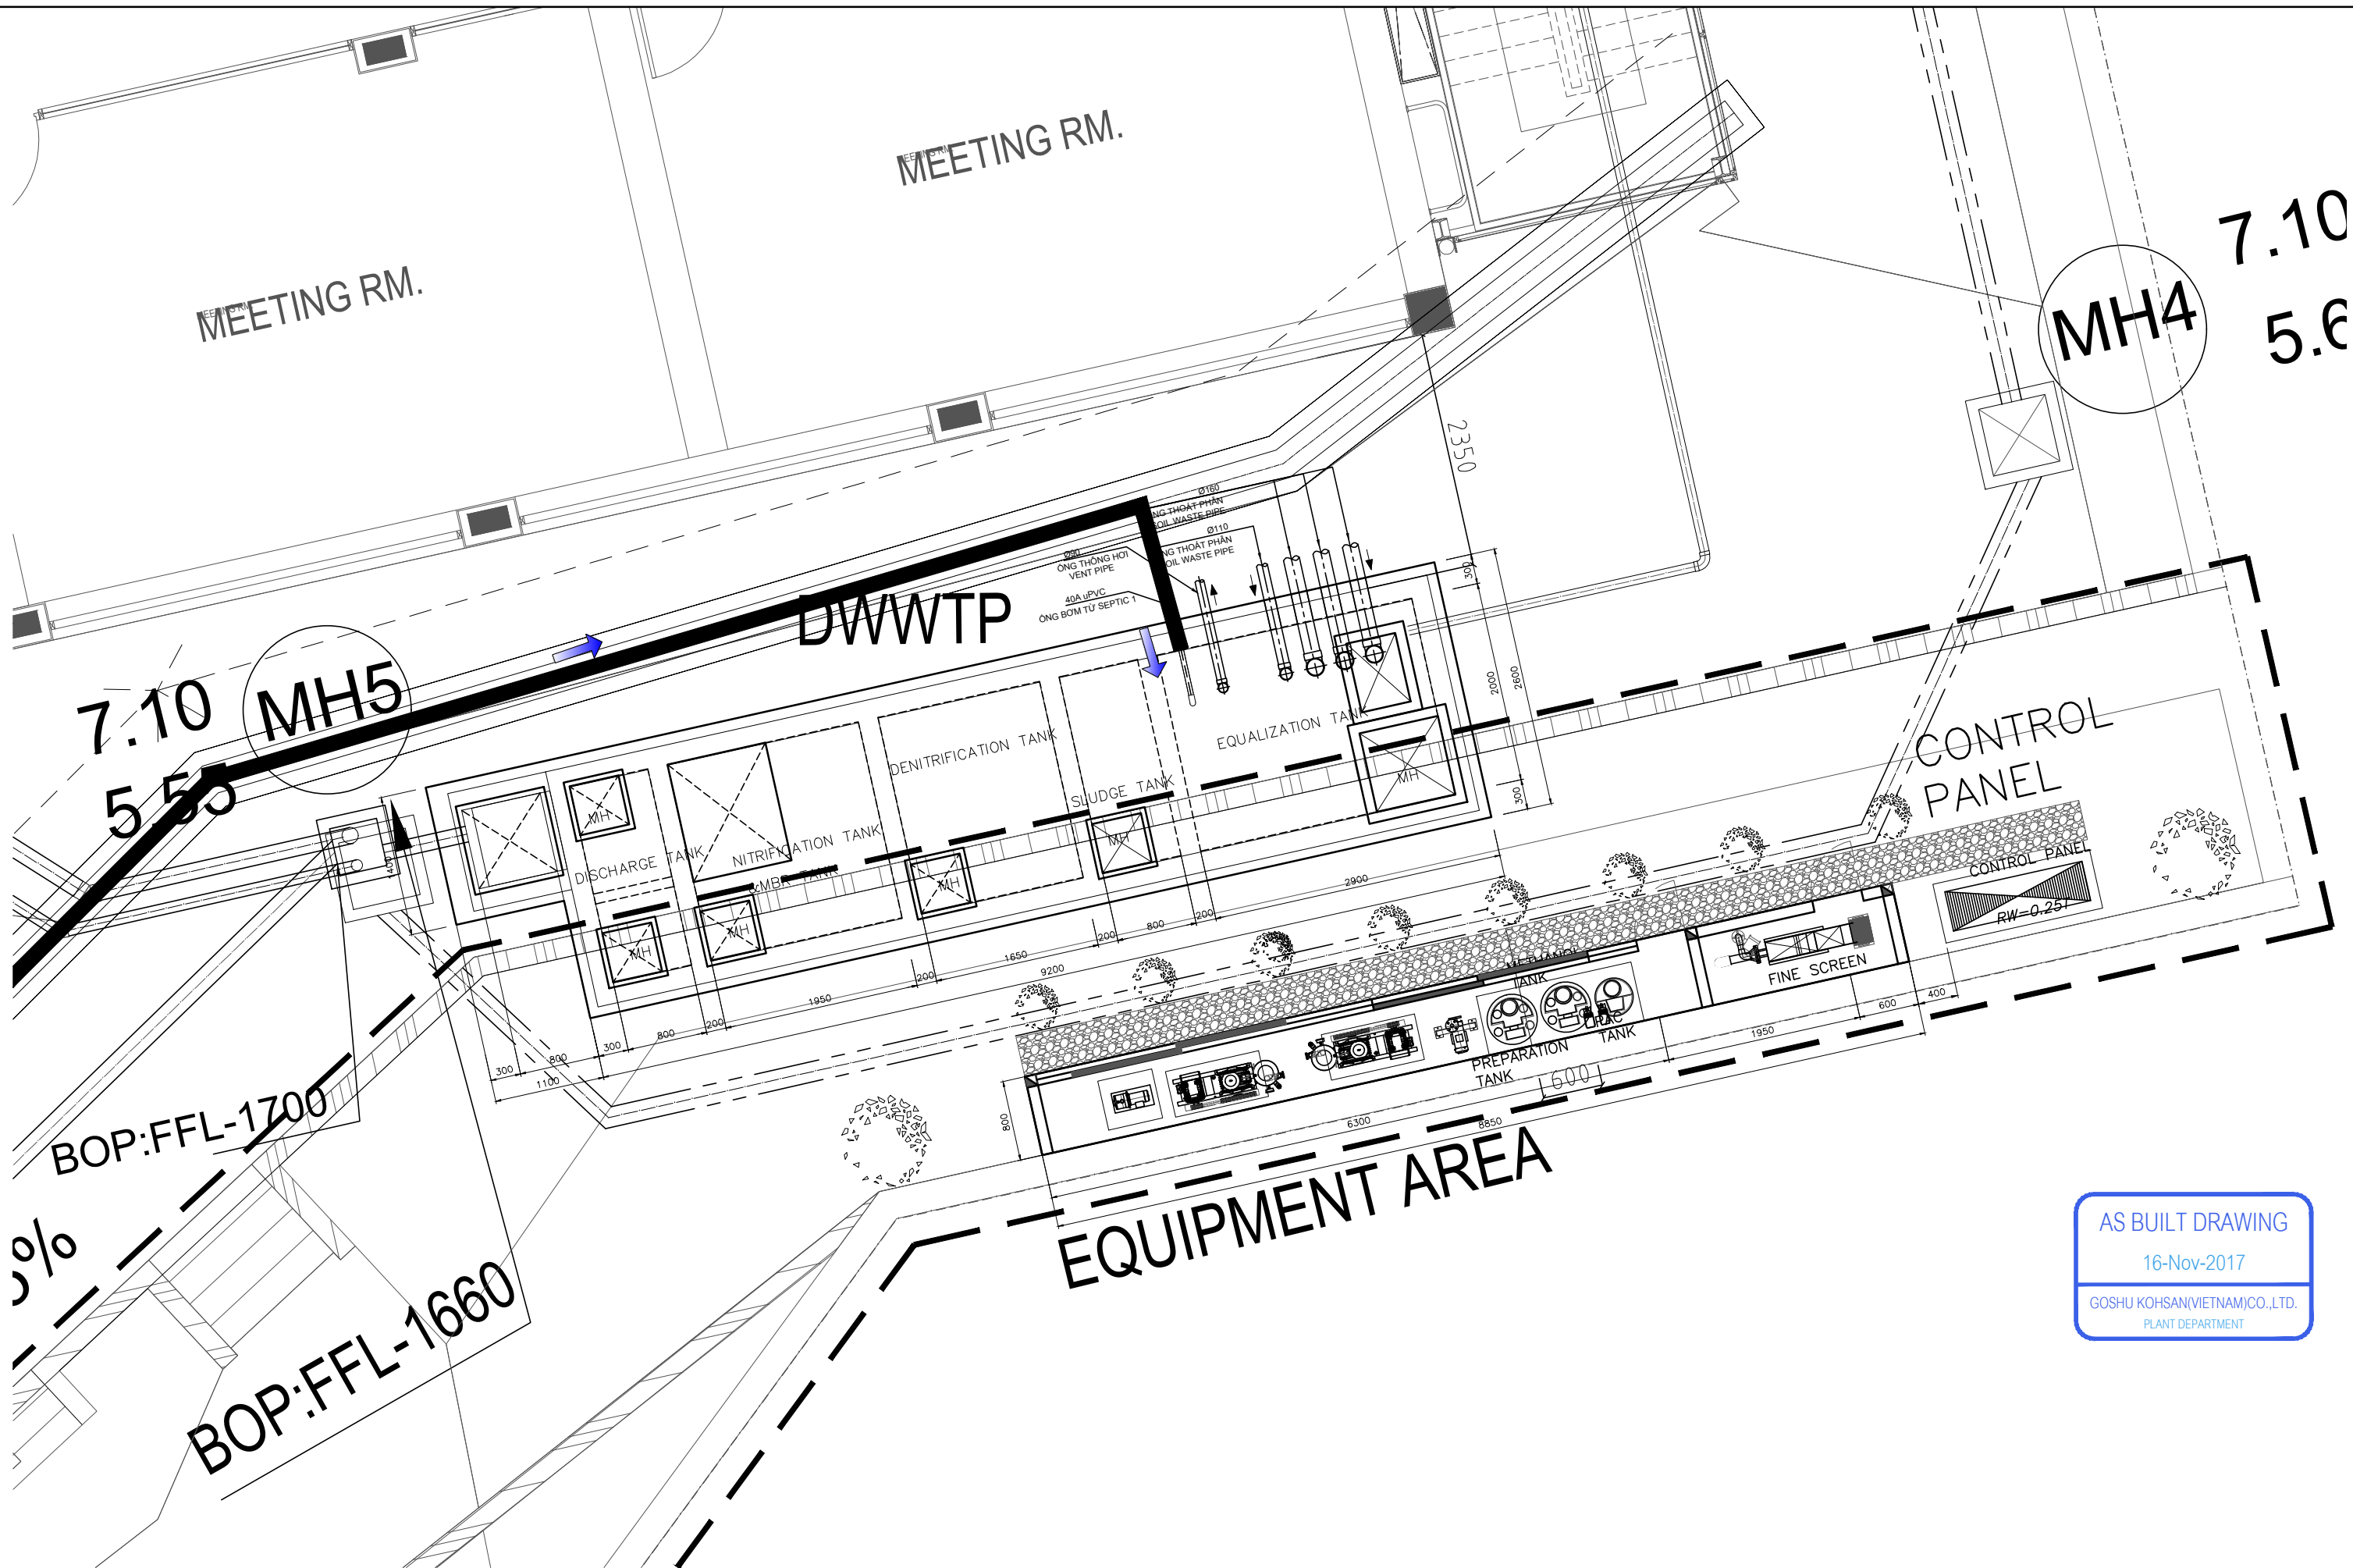


AS BUILT DRAWING  
16-Nov-2017  
GOSHU KOHSAN(VIETNAM)CO.,LTD.  
PLANT DEPARTMENT

|                 |            |                                                    |            |         |                    |               |                                      |                                                                                                                                                                                                                                                                                     |           |           |             |            |             |                                      |           |              |
|-----------------|------------|----------------------------------------------------|------------|---------|--------------------|---------------|--------------------------------------|-------------------------------------------------------------------------------------------------------------------------------------------------------------------------------------------------------------------------------------------------------------------------------------|-----------|-----------|-------------|------------|-------------|--------------------------------------|-----------|--------------|
| Revision Record | 20/6/2017  | Remove NaOH tank, 1pcs MBR filtered pump           | Sales      | Messrs. | GREEN ONE UN HOUSE | Project Name. | DOMESTIC WASTE WATER TREATMENT PLANT |  GOSHU KOHSAN (VIETNAM) CO.,LTD.<br>HANOI HEAD OFFICE<br>LOT P1, THANG LONG IP, DONG ANH DIST,<br>HANOI, VIETNAM.<br><a href="http://www.goshukohsan.com.vn">http://www.goshukohsan.com.vn</a> | Designer  | D.G.LONG  | Dwg. Date   | 07/12/2016 | Item.       | DOMESTIC WASTE WATER TREATMENT PLANT | Rev. No.  | 00           |
|                 | 12/4/2017  | Change capacity of blower: 1.1Nm3/min->1.39Nm3/min | Sales      |         |                    |               |                                      |                                                                                                                                                                                                                                                                                     | Check.    | T.X.THANH | Issued Date | 16/11/2017 | Dwg. Title. | GENERAL LAYOUT                       | Scale     | N/A          |
|                 | 07/12/2016 | First issue                                        | Sales      |         |                    |               |                                      |                                                                                                                                                                                                                                                                                     | Approved. | NG.VY     | Drawn By.   | C.V.HQA    | Job No.     |                                      | Dwg. Code | DWWTP-ME-102 |
|                 |            | Content                                            | Request by |         |                    |               |                                      |                                                                                                                                                                                                                                                                                     |           |           |             |            |             |                                      |           |              |





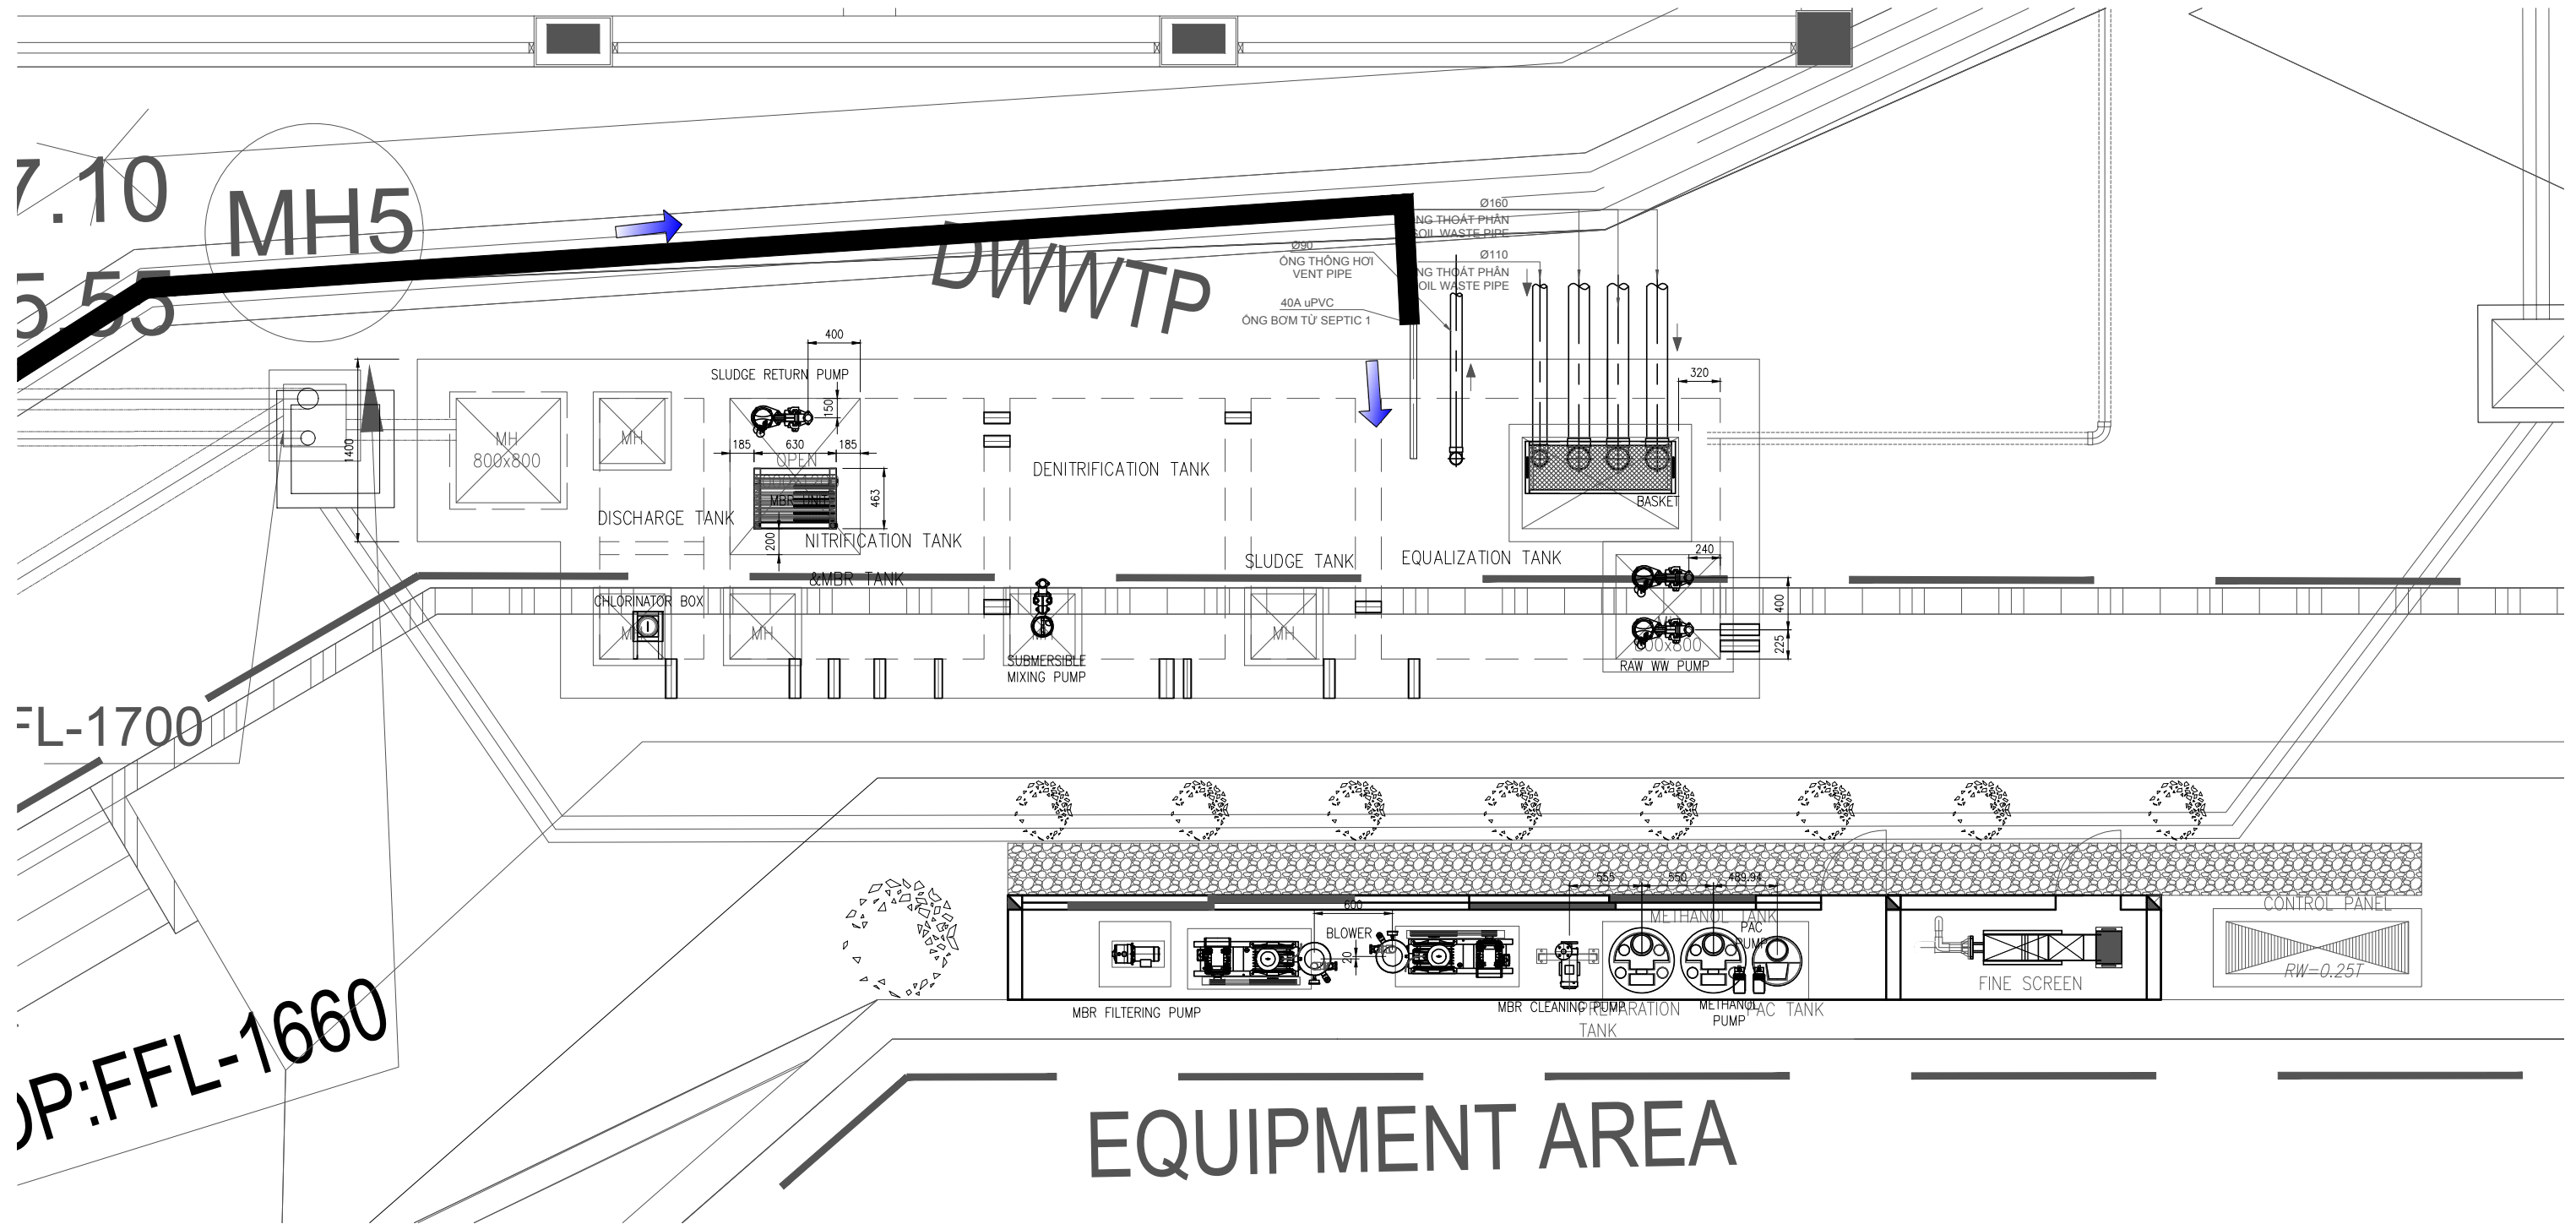


EQUIPMENT LAYOUT

AS BUILT DRAWING

16-Nov-2017

GOSHU KOHSAN(VIETNAM)CO.,LTD.  
PLANT DEPARTMENT





|                 |      |       |         |            |                    |                                     |                                                                                                                                                                                                                                          |           |           |             |            |             |                                     |           |             |
|-----------------|------|-------|---------|------------|--------------------|-------------------------------------|------------------------------------------------------------------------------------------------------------------------------------------------------------------------------------------------------------------------------------------|-----------|-----------|-------------|------------|-------------|-------------------------------------|-----------|-------------|
| Revision Record | Rev. | Date. | Content | Request BY | Messrs.            | Project Name.                       | <div><div></div><div>GOSHU KOHSAN (VIETNAM) CO.,LTD.</div><div>HANOI HEAD OFFICE<br/>LOT P1, THANG LONG IP, DONG ANH DIST,<br/>HANOI, VIETNAM.<br/><a href="http://www.goshukohsan.com.vn">http://www.goshukohsan.com.vn</a></div></div> | Designer  | D.G.LONG  | Dwg. Date   | 10/08/2017 | Item.       | DOMESTIC WASTEWATER TREATMENT PLANT | Rev. No.  | 00          |
|                 |      |       |         |            | GREEN ONE UN HOUSE | DOMESTIC WASTEWATER TREATMENT PLANT |                                                                                                                                                                                                                                          | Check.    | T.X.THANH | Issued Date | 16/11/2017 | Dwg. Title. | EQUIPMENT LAYOUT                    | Scale     | NONE        |
|                 |      |       |         |            |                    |                                     |                                                                                                                                                                                                                                          | Approved. | NG.VY     | Drawn By.   | C.V.HOA    | Job No.     |                                     | Dwg. Code | DWWT-ME-200 |
|                 |      |       |         |            |                    |                                     |                                                                                                                                                                                                                                          |           |           |             |            |             |                                     |           |             |

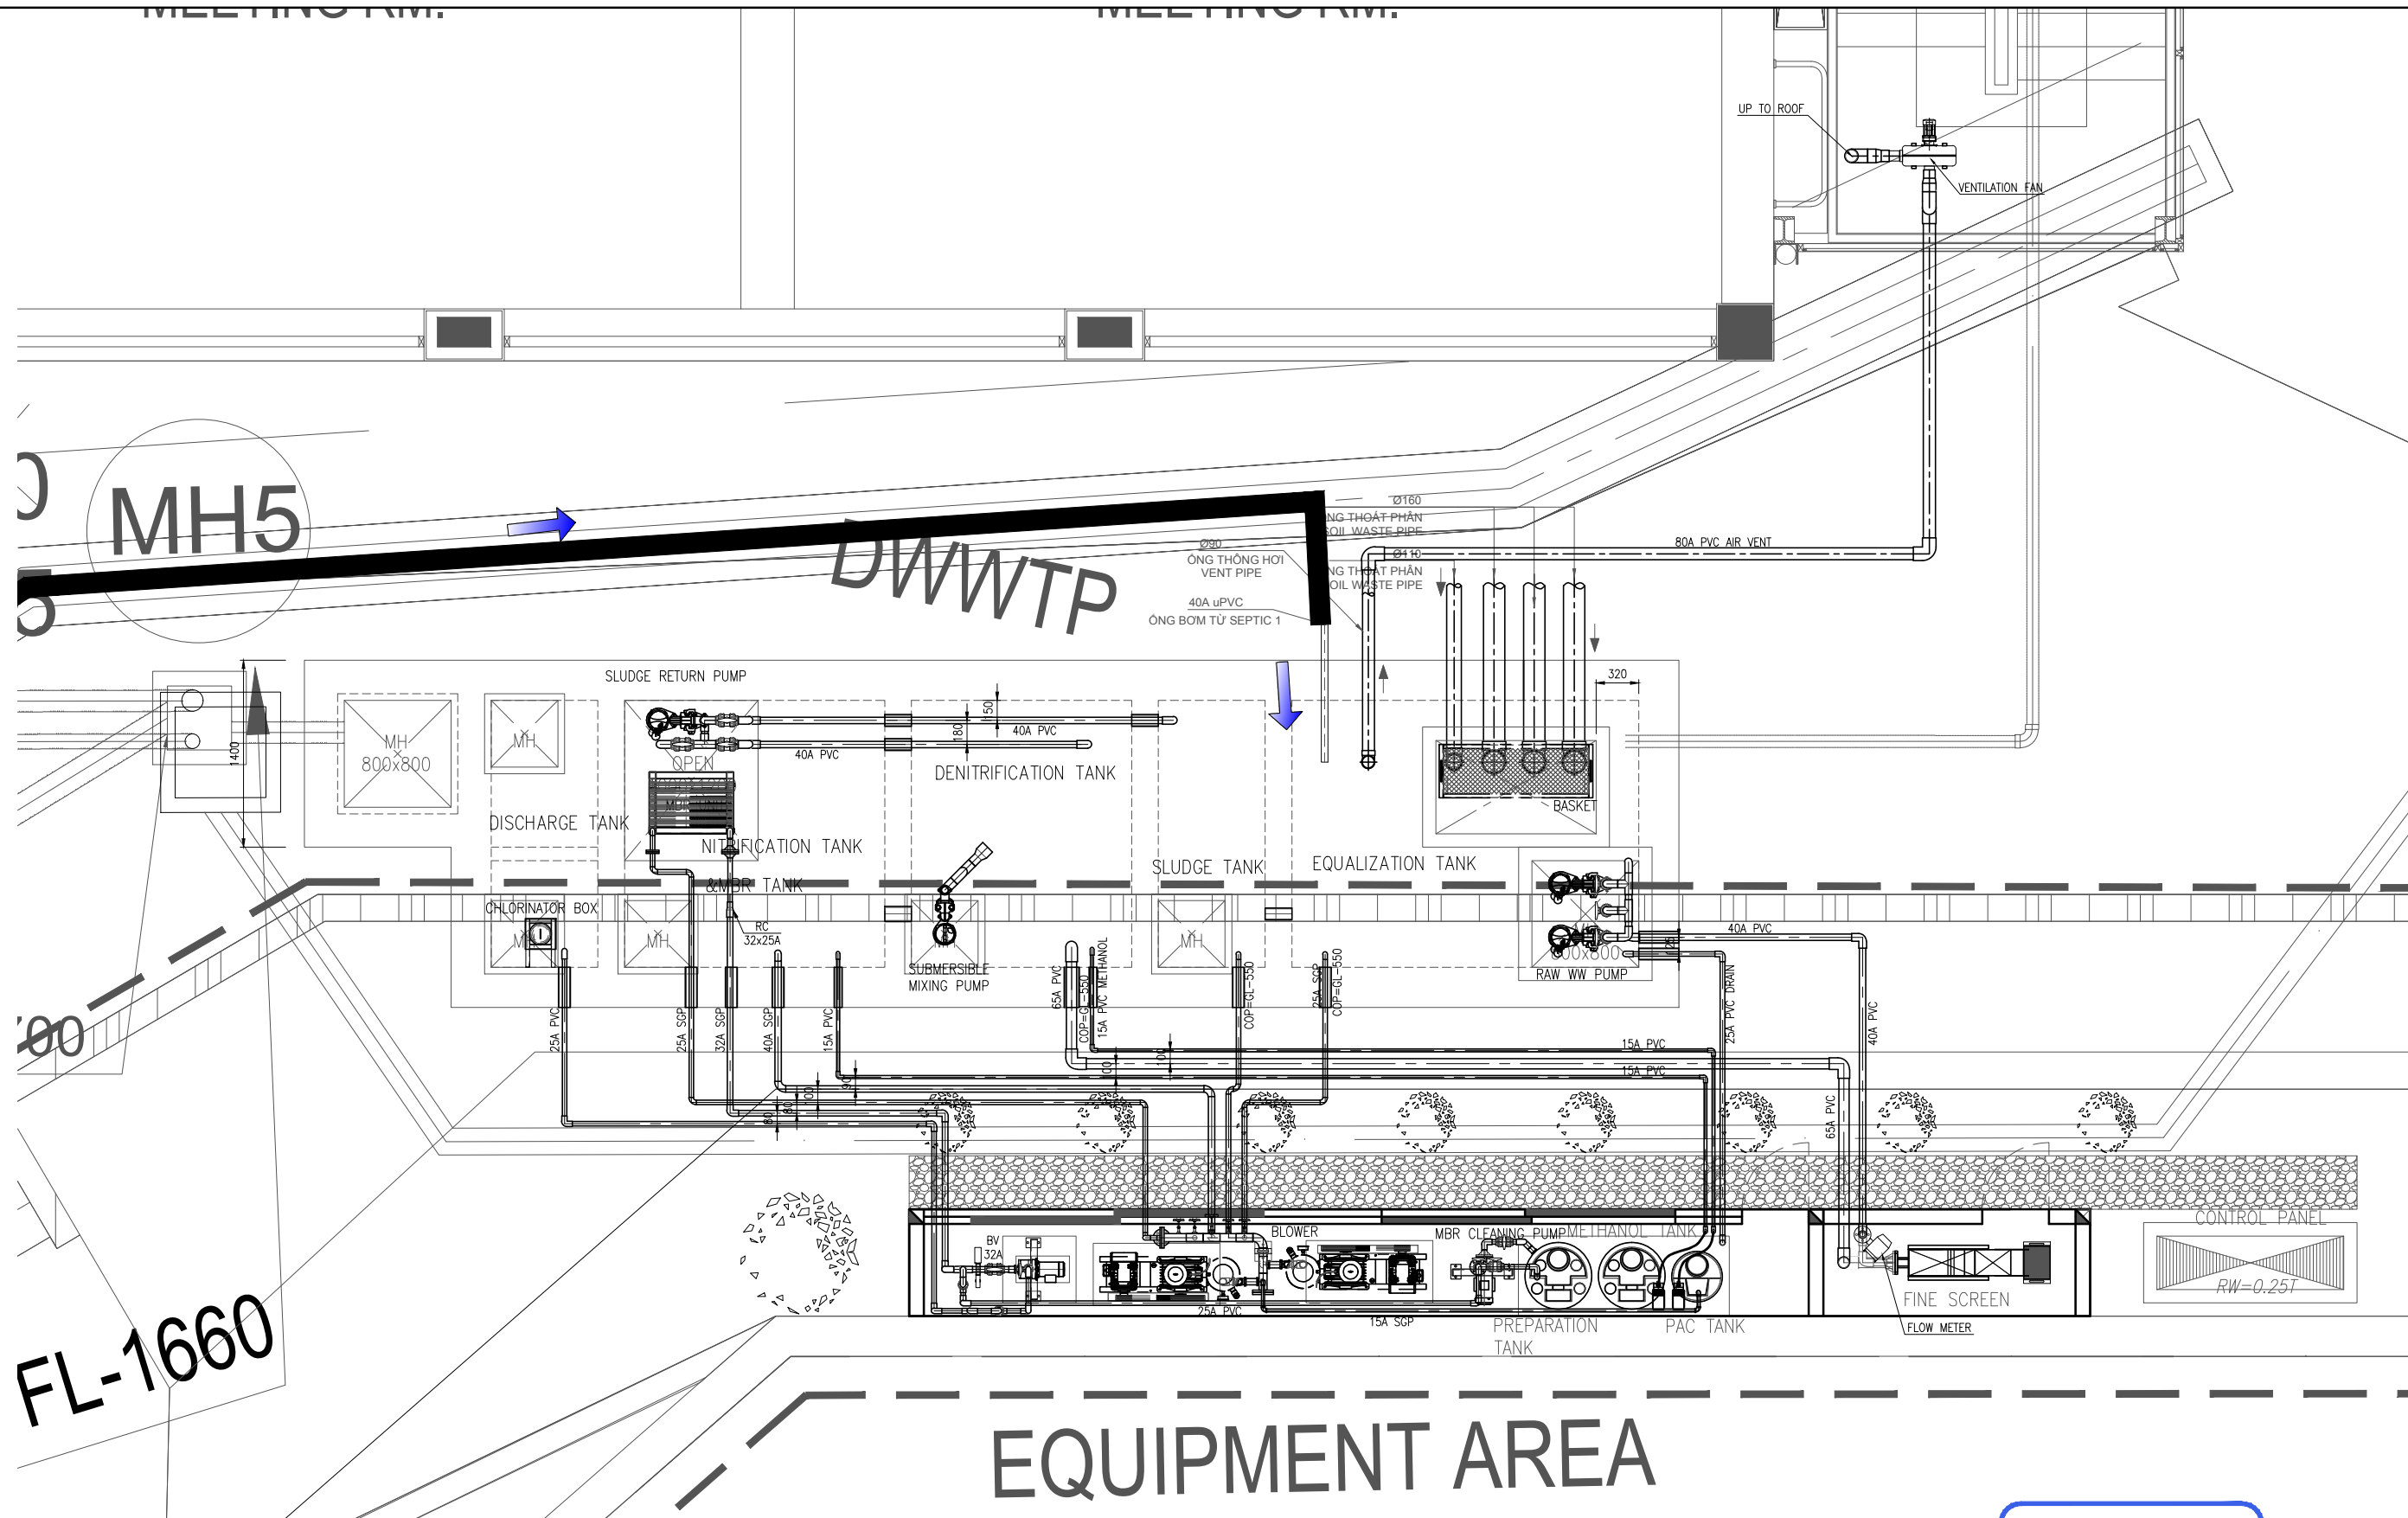

PIPING LAYOUT  
1:20

AS BUILT DRAWING  
16-Nov-2017  
GOSHU KOHSAN(VIETNAM)CO.,LTD.  
PLANT DEPARTMENT

|                 |      |       |         |            |         |                    |                                                                                                                                                                                               |           |           |             |            |             |                                     |           |             |
|-----------------|------|-------|---------|------------|---------|--------------------|-----------------------------------------------------------------------------------------------------------------------------------------------------------------------------------------------|-----------|-----------|-------------|------------|-------------|-------------------------------------|-----------|-------------|
| Revision Record | Rev. | Date. | Content | Request By | Messrs. | Project Name.      | GOSHU KOHSAN (VIETNAM) CO.,LTD.<br>HANOI HEAD OFFICE<br>LOT P1, THANG LONG IP, DONG ANH DIST,<br>HANOI, VIETNAM.<br><a href="http://www.goshukohsan.com.vn">http://www.goshukohsan.com.vn</a> | Designer  | D.G.LONG  | Dwg. Date   | 10/08/2017 | Item.       | DOMESTIC WASTEWATER TREATMENT PLANT | Rev. No.  | 00          |
|                 |      |       |         |            |         | GREEN ONE UN HOUSE |                                                                                                                                                                                               | Check.    | T.X.THANH | Issued Date | 16/11/2017 | Dwg. Title. | PIPING LAYOUT                       | Scale     | NONE        |
|                 |      |       |         |            |         |                    |                                                                                                                                                                                               | Approved. | NG.VY     | Drawn By.   | C.V.HOA    | Job No.     |                                     | Dwg. Code | DWWT-ME-201 |

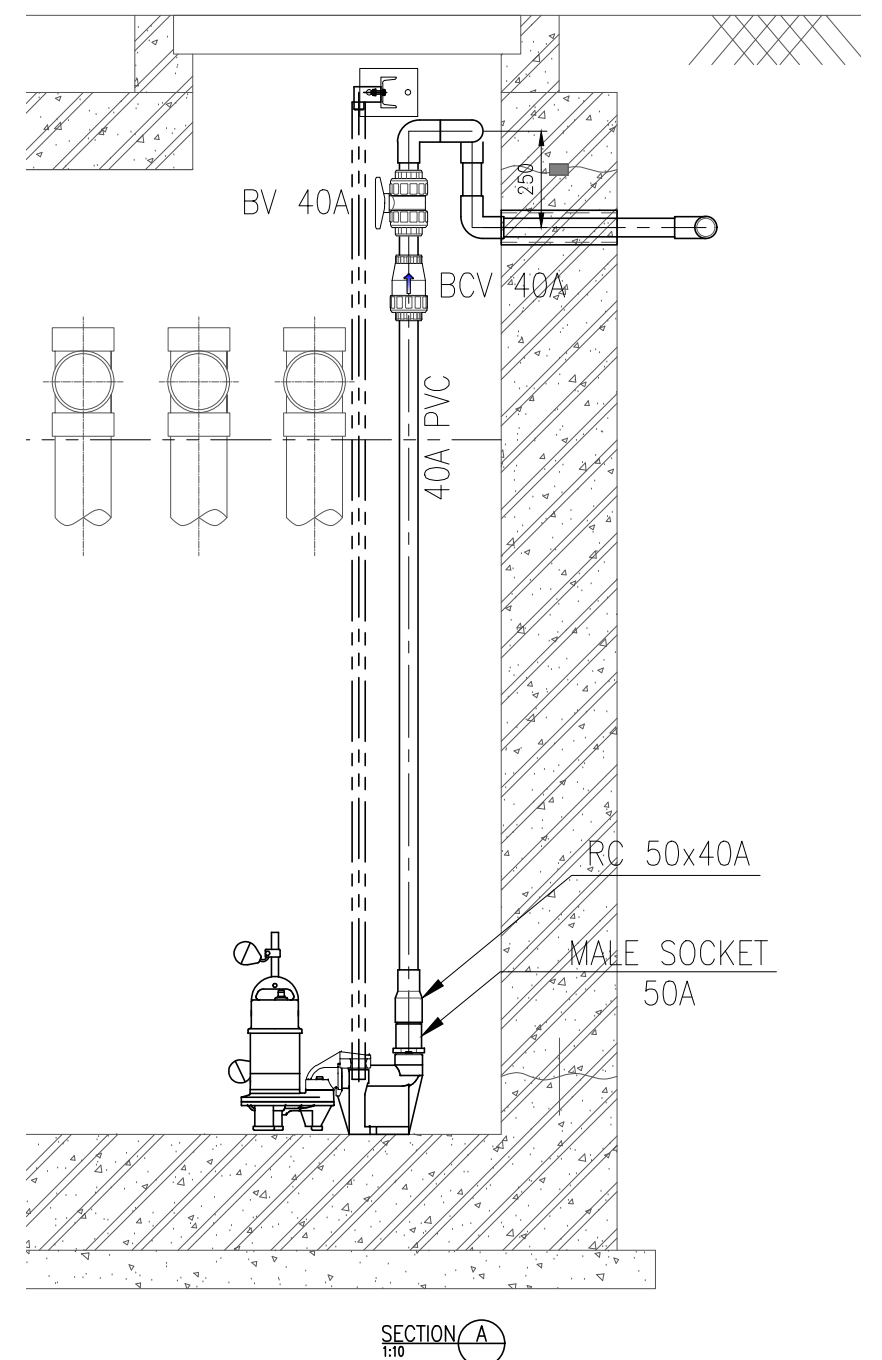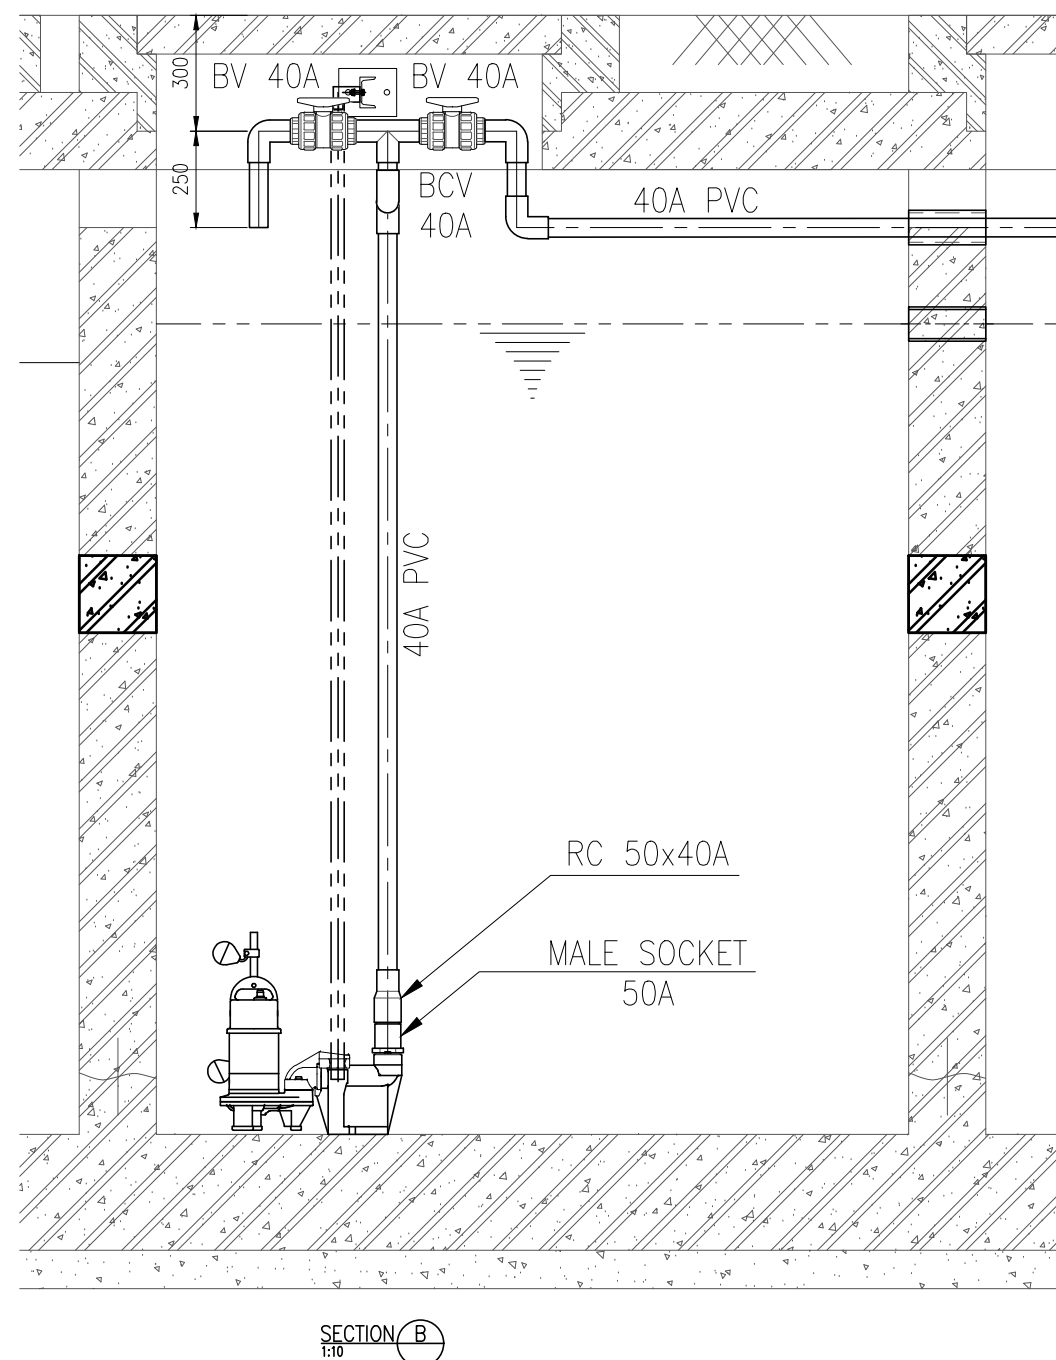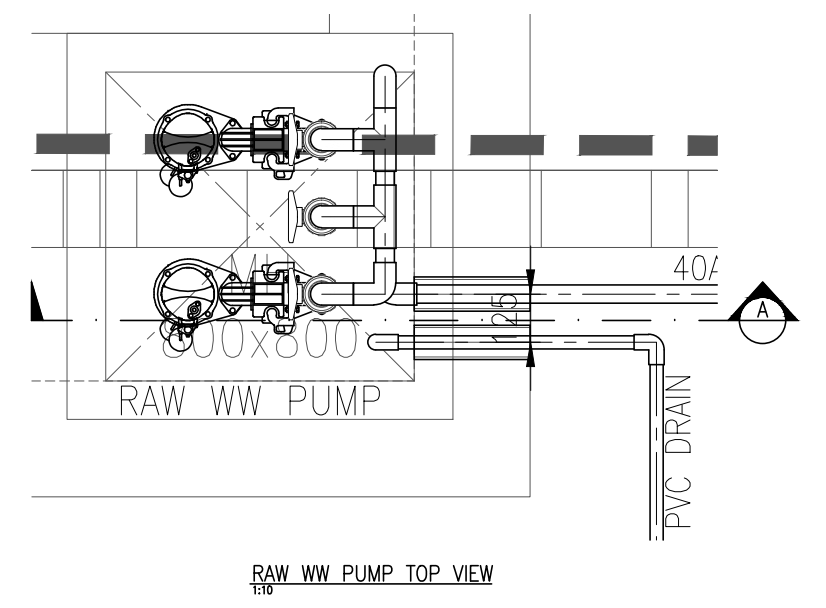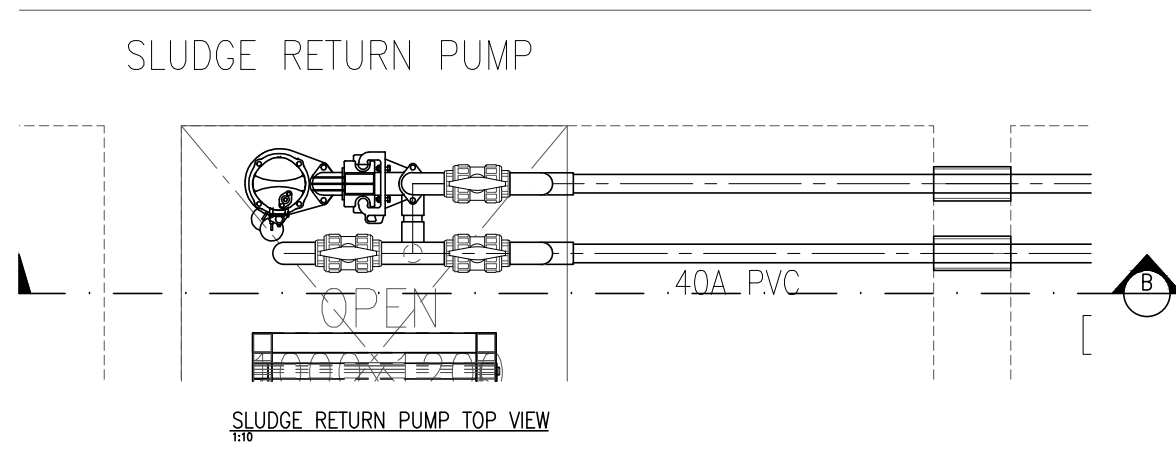

AS BUILT DRAWING

16-Nov-2017

GOSHU KOHSAN (VIET NAM) CO.,LTD.  
PLANT DEPARTMENT

| Rev. | Date. | Content | Request By |
|------|-------|---------|------------|
|      |       |         |            |
|      |       |         |            |
|      |       |         |            |


|               |                                     |
|---------------|-------------------------------------|
| Messrs.       | GREEN ONE UN HOUSE                  |
| Project Name. | DOMESTIC WASTEWATER TREATMENT PLANT |

|               |                                     |
|---------------|-------------------------------------|
| Project Name. | DOMESTIC WASTEWATER TREATMENT PLANT |
|---------------|-------------------------------------|


|                                                                           |
|---------------------------------------------------------------------------|
| GOSHU KOHSAN (VIETNAM) CO.,LTD.                                           |
| HANOI HEAD OFFICE                                                         |
| LOT P1, THANG LONG IP, DONG ANH DIST,                                     |
| HANOI, VIETNAM.                                                           |
| <a href="http://www.goshukohsan.com.vn">http://www.goshukohsan.com.vn</a> |

|           |           |             |            |
|-----------|-----------|-------------|------------|
| Designer  | D.G.LONG  | Dwg. Date   | 23/08/2017 |
| Check.    | T.X.THANH | Issued Date | 16/11/2017 |
| Approved. | NG.VY     | Drawn By.   | C.V.HOA    |


|             |                                     |           |             |
|-------------|-------------------------------------|-----------|-------------|
| Item.       | DOMESTIC WASTEWATER TREATMENT PLANT | Rev. No.  | 00          |
| Dwg. Title. | RAW WW PUMP & SLUDGE RETURN PUMP    | Scale     | NONE        |
| Job No.     |                                     | Dwg. Code | DWWT-ME-301 |

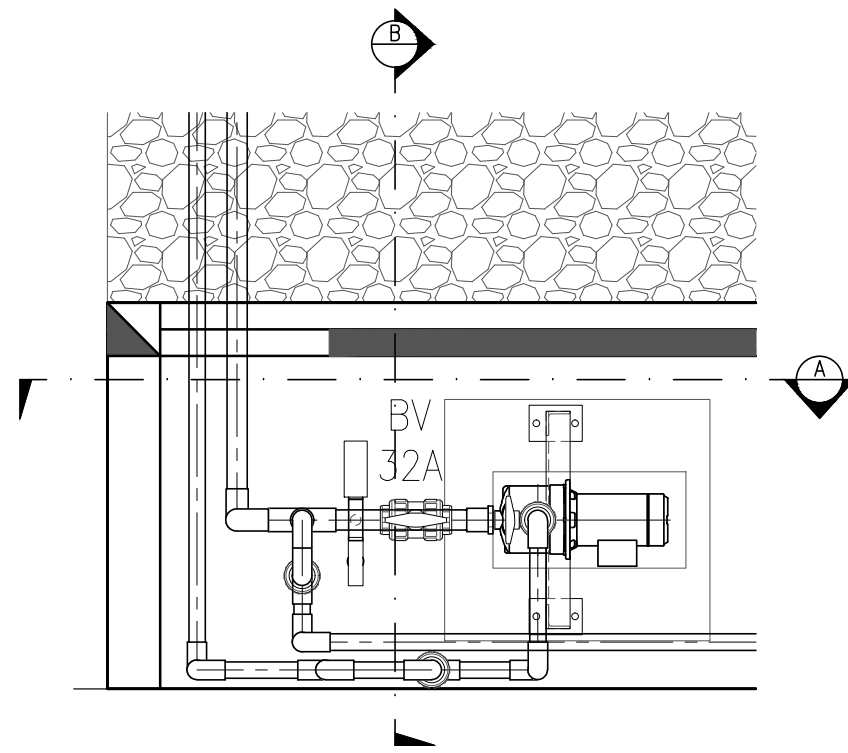

TOP VIEW  
1:8

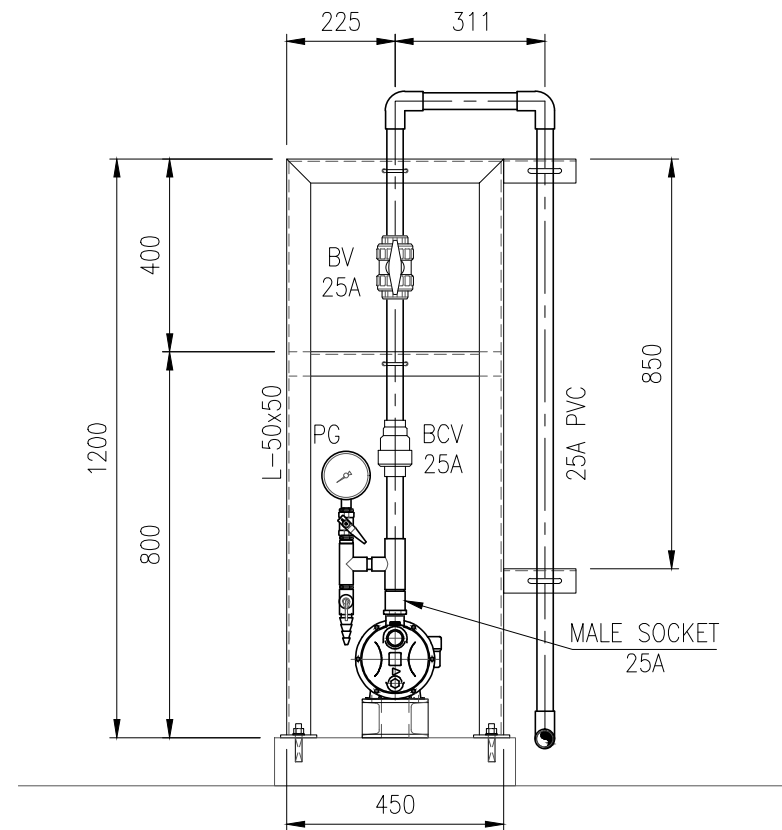

SECTION A  
1:8

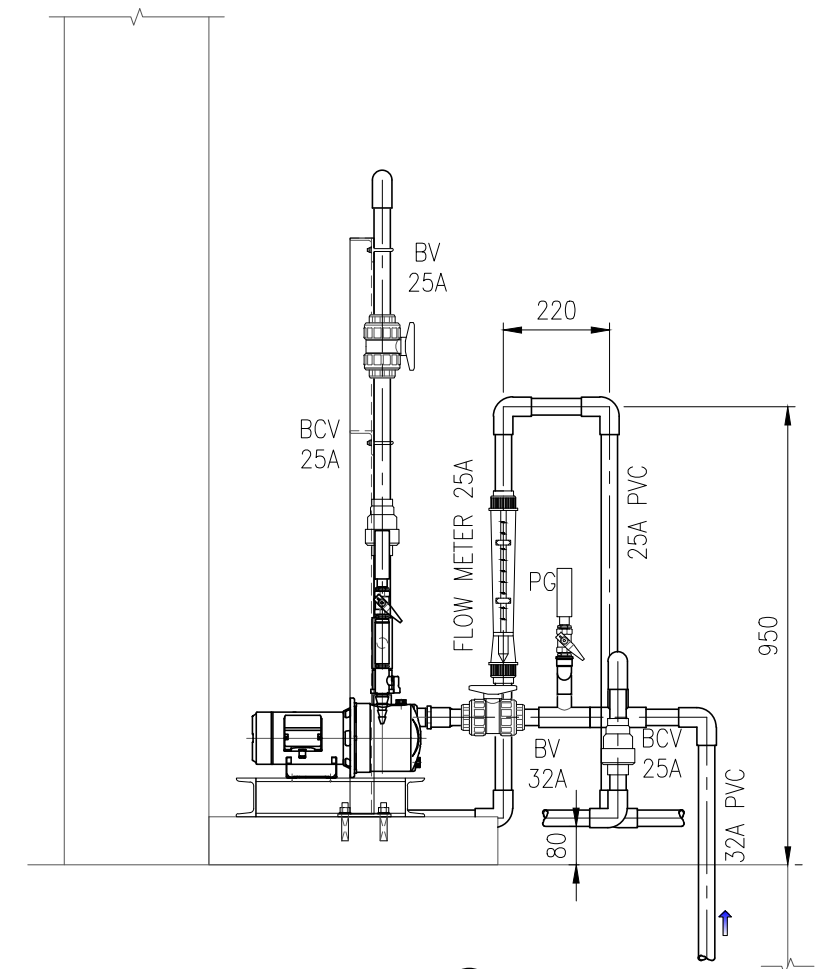

SECTION B  
1:8

AS BUILT DRAWING

16-Nov-2017

GOSHU KOHSAN (VIET NAM) CO.,LTD.  
PLANT DEPARTMENT

| Rev. | Date. | Content | Request BY |
|------|-------|---------|------------|
|      |       |         |            |
|      |       |         |            |
|      |       |         |            |

Messrs.

GREEN ONE UN HOUSE

Project Name.

DOMESTIC WASTEWATER TREATMENT PLANT



GOSHU KOHSAN (VIETNAM) CO.,LTD.

HANOI HEAD OFFICE  
LOT P1, THANG LONG IP, DONG ANH DIST,  
HANOI, VIETNAM.  
<http://www.goshukohsan.com.vn>

Designer

D.G.LONG

Dwg. Date

23/08/2017

Check.

T.X.THANH

Issued Date

16/11/2017

Approved.

NG.VY

Drawn By.

C.V.HOA

Item.

DOMESTIC WASTEWATER TREATMENT PLANT

Dwg. Title.

MBR FILTERED PUMP

Job No.

Dwg. Code


DWWT-ME-302

Rev. No.


00

Scale


NONE

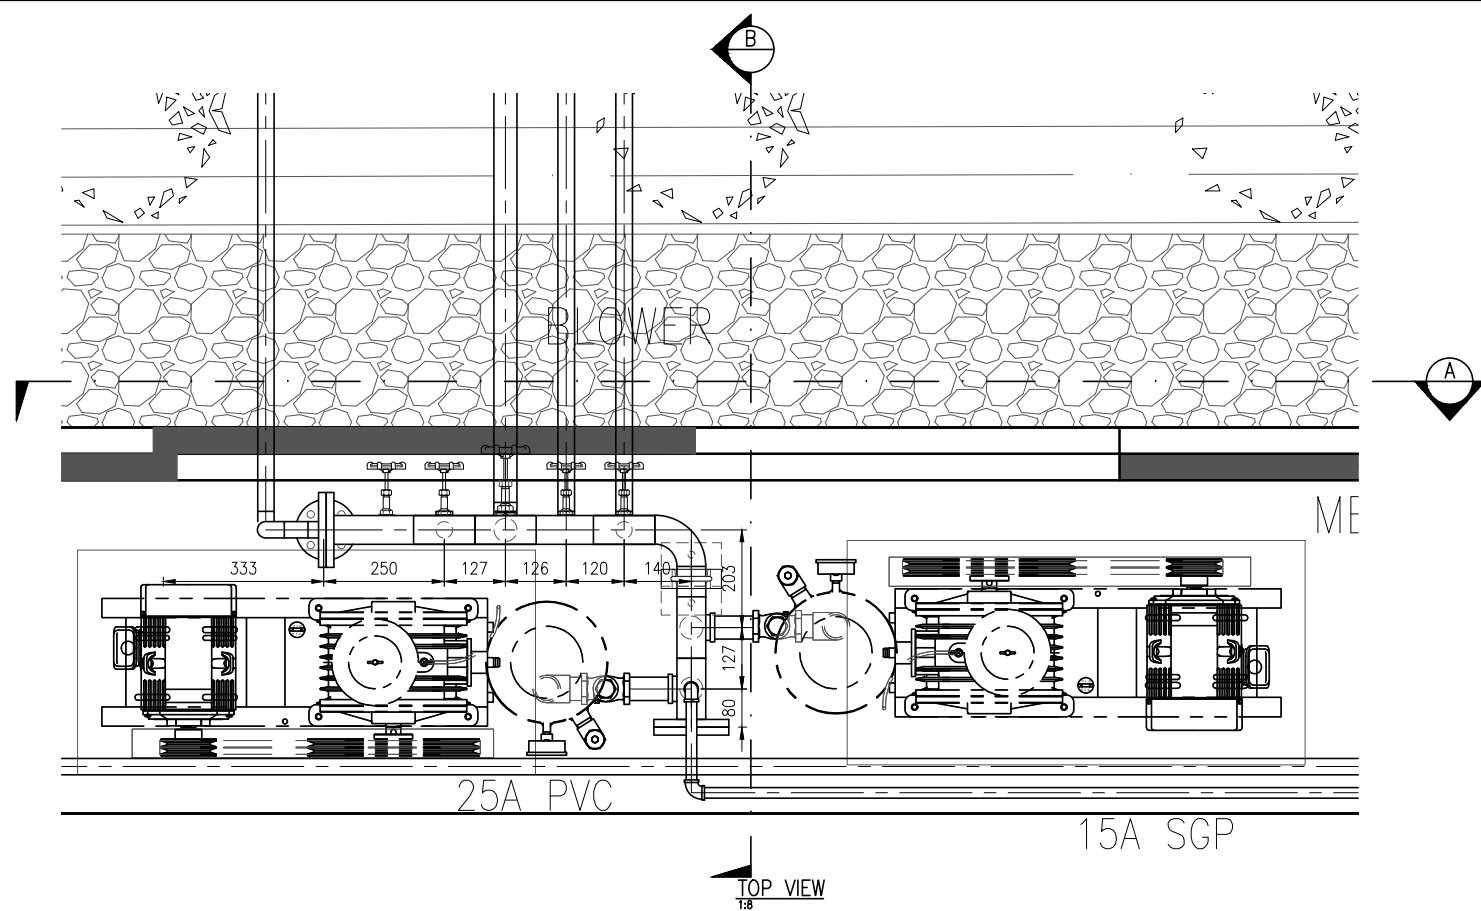

AS BUILT DRAWING  
16-Nov-2017  
GOSHU KOHSAN (VIET NAM) CO.,LTD.  
PLANT DEPARTMENT

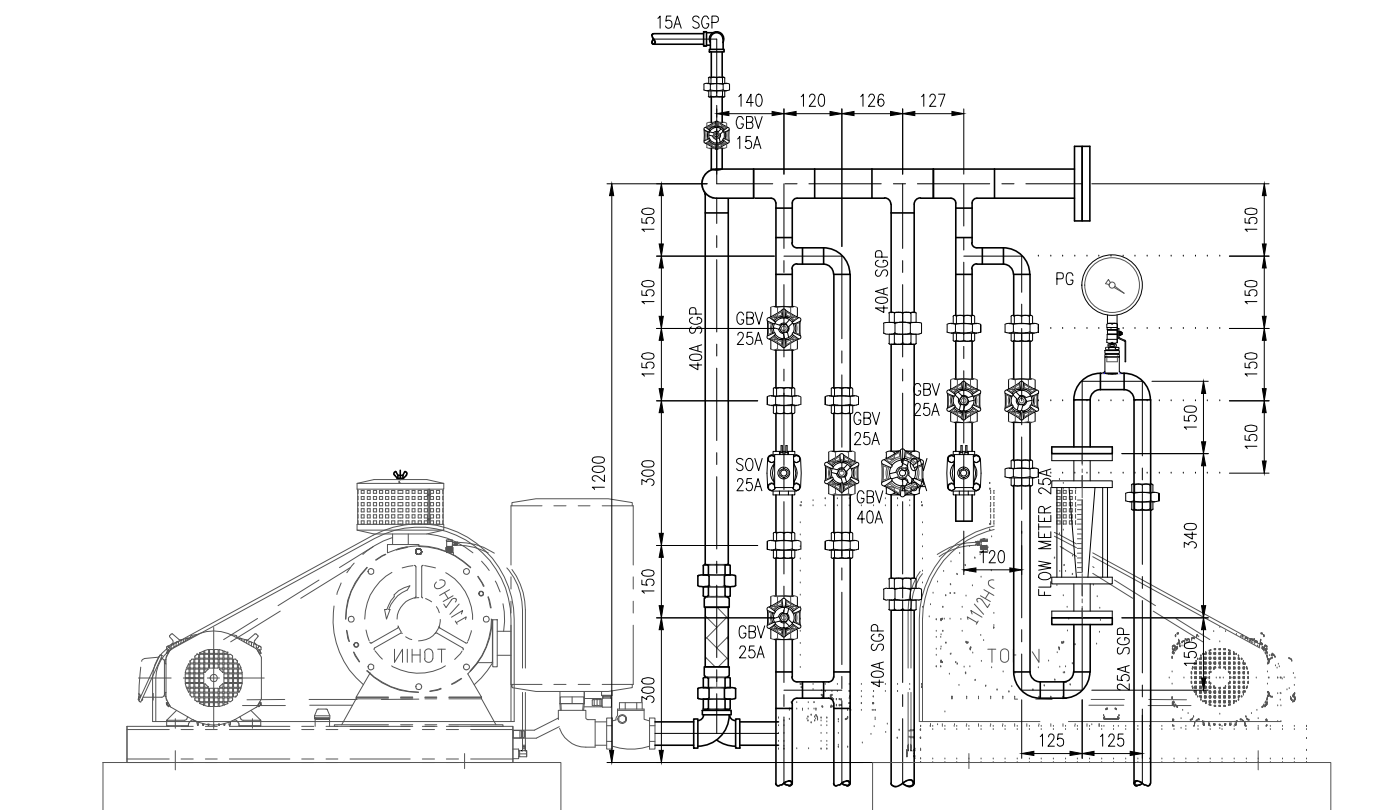

SECTION A  
1:8

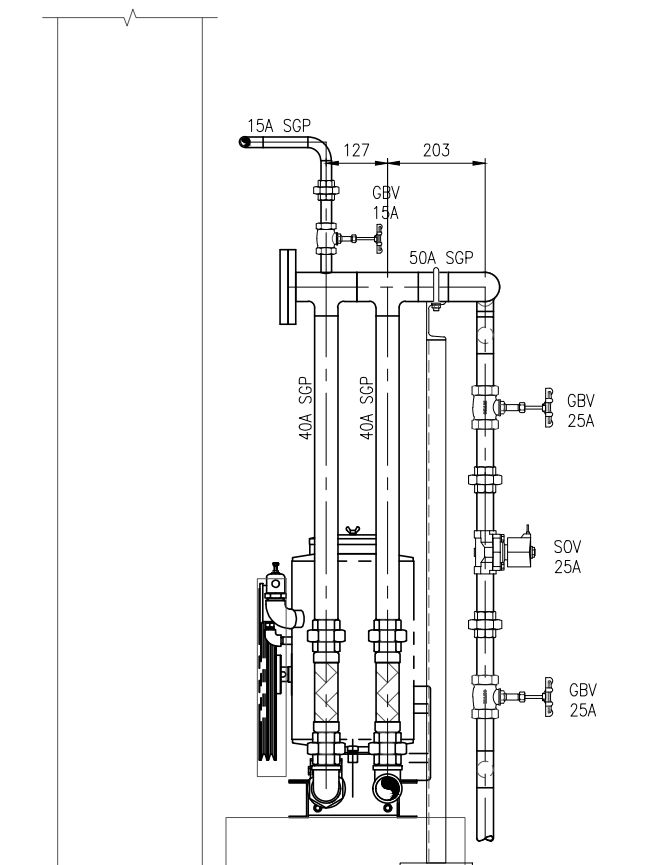


SECTION B  
1:8

|                 |      |       |         |            |                    |                                     |                                                                                                                                                                                                      |           |           |             |            |             |                                     |           |             |
|-----------------|------|-------|---------|------------|--------------------|-------------------------------------|------------------------------------------------------------------------------------------------------------------------------------------------------------------------------------------------------|-----------|-----------|-------------|------------|-------------|-------------------------------------|-----------|-------------|
| Revision Record | Rev. | Date. | Content | Request By | Messrs.            | Project Name.                       | <b>GOSHU KOHSAN (VIETNAM) CO.,LTD.</b><br>HANOI HEAD OFFICE<br>LOT P1, THANG LONG IP, DONG ANH DIST,<br>HANOI, VIETNAM.<br><a href="http://www.goshukohsan.com.vn">http://www.goshukohsan.com.vn</a> | Designer  | D.G.LONG  | Dwg. Date   | 23/08/2017 | Item.       | DOMESTIC WASTEWATER TREATMENT PLANT | Rev. No.  | 00          |
|                 |      |       |         |            | GREEN ONE UN HOUSE | DOMESTIC WASTEWATER TREATMENT PLANT |                                                                                                                                                                                                      | Check.    | T.X.THANH | Issued Date | 16/11/2017 | Dwg. Title. | BLOWER DETAIL                       | Scale     | NONE        |
|                 |      |       |         |            |                    |                                     |                                                                                                                                                                                                      | Approved. | NG.VY     | Drawn By.   | C.V.HOA    | Job No.     |                                     | Dwg. Code | DWWT-ME-303 |
|                 |      |       |         |            |                    |                                     |                                                                                                                                                                                                      |           |           |             |            |             |                                     |           |             |


AS BUILT DRAWING

16-Nov-2017


GOSHU KOHSAN (VIET NAM) CO.,LTD.  
PLANT DEPARTMENT

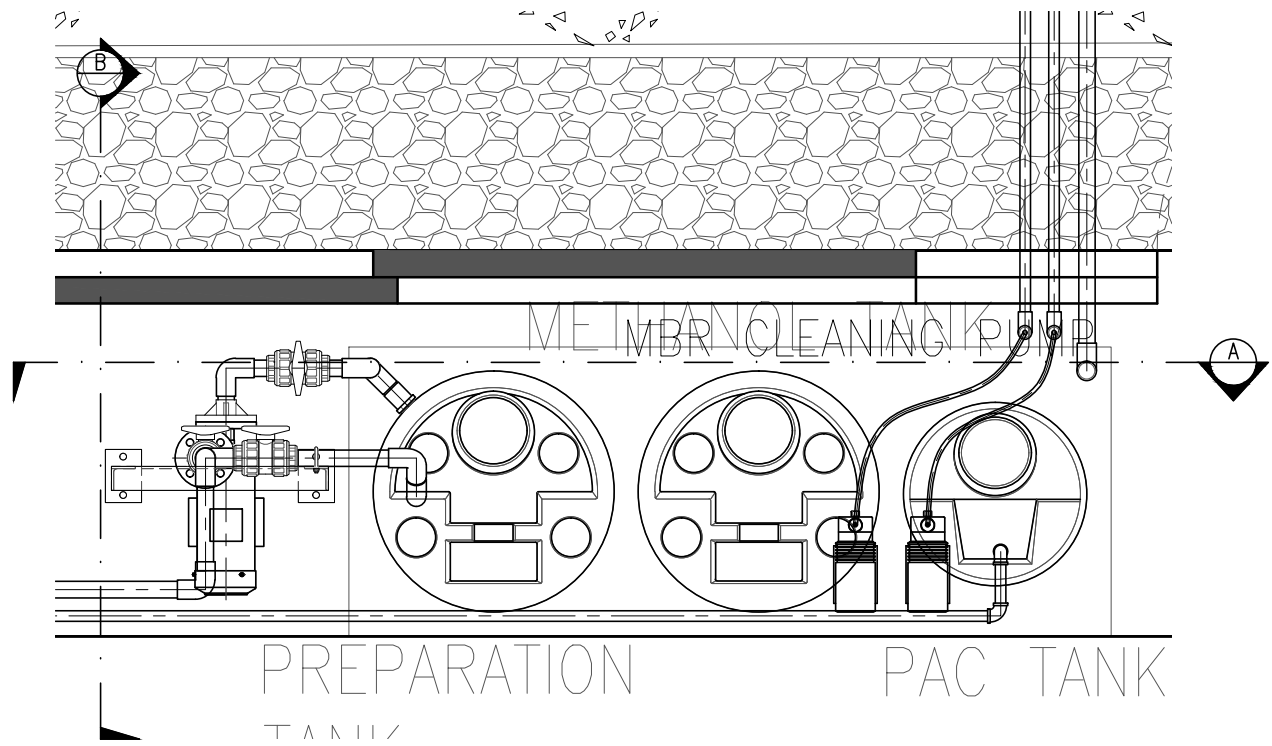

TOP VIEW  
1:8

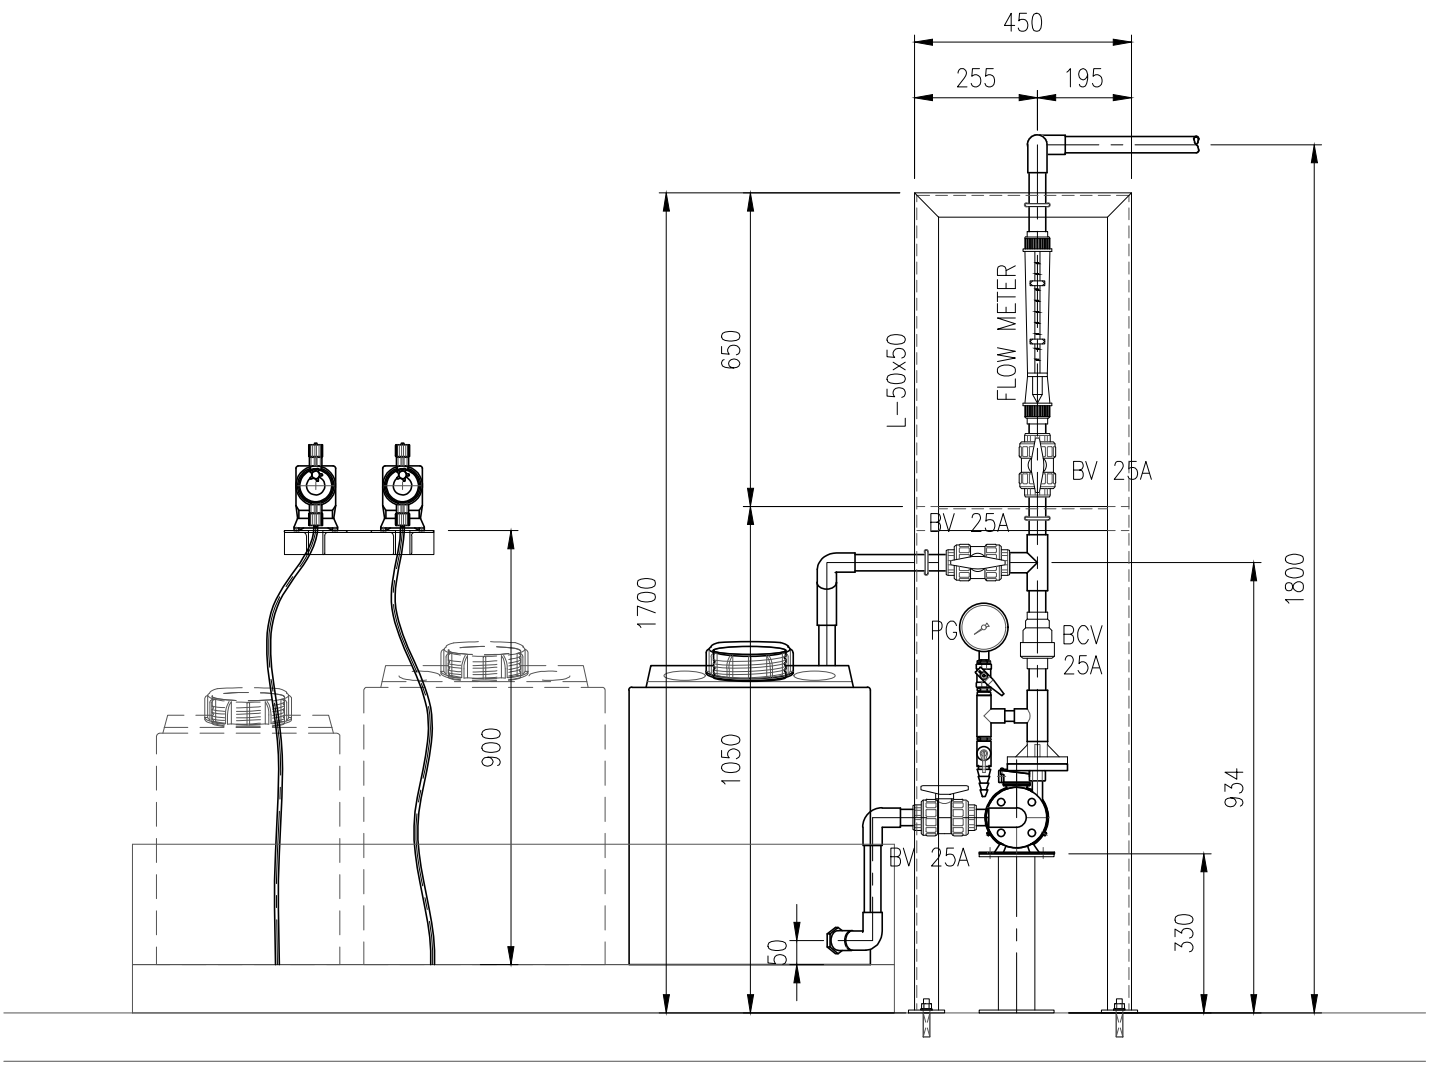


SECTION A  
1:8

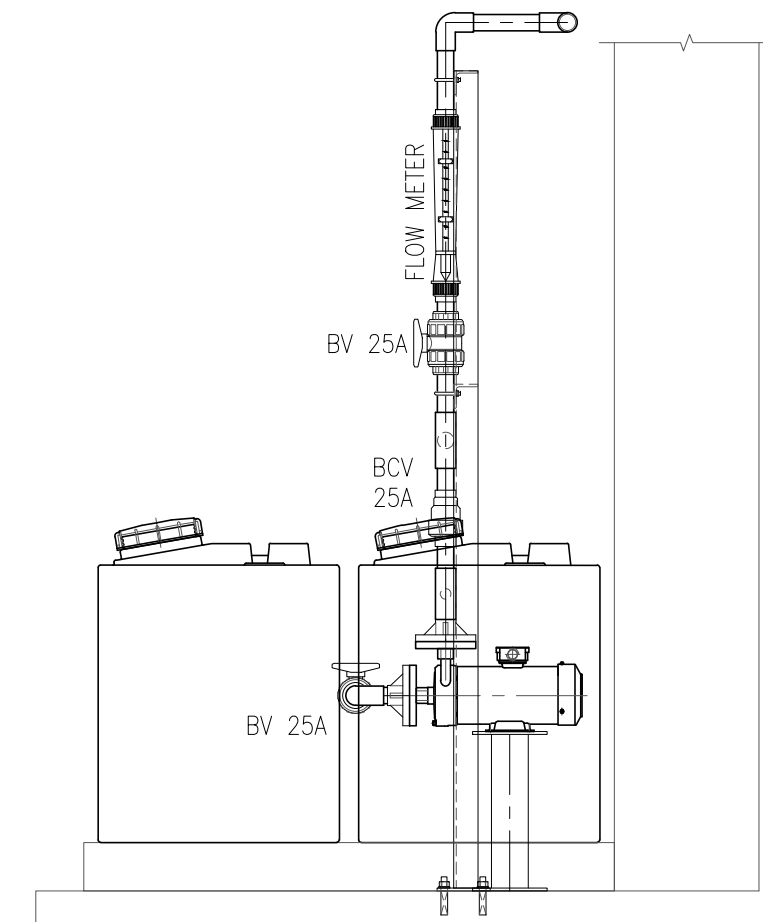


SECTION B  
1:8


|                 |      |       |         |            |                    |                                     |                                                                                                                                                                                                                                          |           |           |             |            |             |                                     |           |             |
|-----------------|------|-------|---------|------------|--------------------|-------------------------------------|------------------------------------------------------------------------------------------------------------------------------------------------------------------------------------------------------------------------------------------|-----------|-----------|-------------|------------|-------------|-------------------------------------|-----------|-------------|
| Revision Record | Rev. | Date. | Content | Request BY | Messrs.            | Project Name.                       | <div><div></div><div>GOSHU KOHSAN (VIETNAM) CO.,LTD.</div><div>HANOI HEAD OFFICE<br/>LOT P1, THANG LONG IP, DONG ANH DIST,<br/>HANOI, VIETNAM.<br/><a href="http://www.goshukohsan.com.vn">http://www.goshukohsan.com.vn</a></div></div> | Designer  | D.G.LONG  | Dwg. Date   | 23/08/2017 | Item.       | DOMESTIC WASTEWATER TREATMENT PLANT | Rev. No.  | 00          |
|                 |      |       |         |            | GREEN ONE UN HOUSE | DOMESTIC WASTEWATER TREATMENT PLANT |                                                                                                                                                                                                                                          | Check.    | T.X.THANH | Issued Date | 16/11/2017 | Dwg. Title. | MBR CLEANING PUMP                   | Scale     | NONE        |
|                 |      |       |         |            |                    |                                     |                                                                                                                                                                                                                                          | Approved. | NG.VY     | Drawn By.   | C.V.HOA    | Job No.     |                                     | Dwg. Code | DWWT-ME-304 |
|                 |      |       |         |            |                    |                                     |                                                                                                                                                                                                                                          |           |           |             |            |             |                                     |           |             |

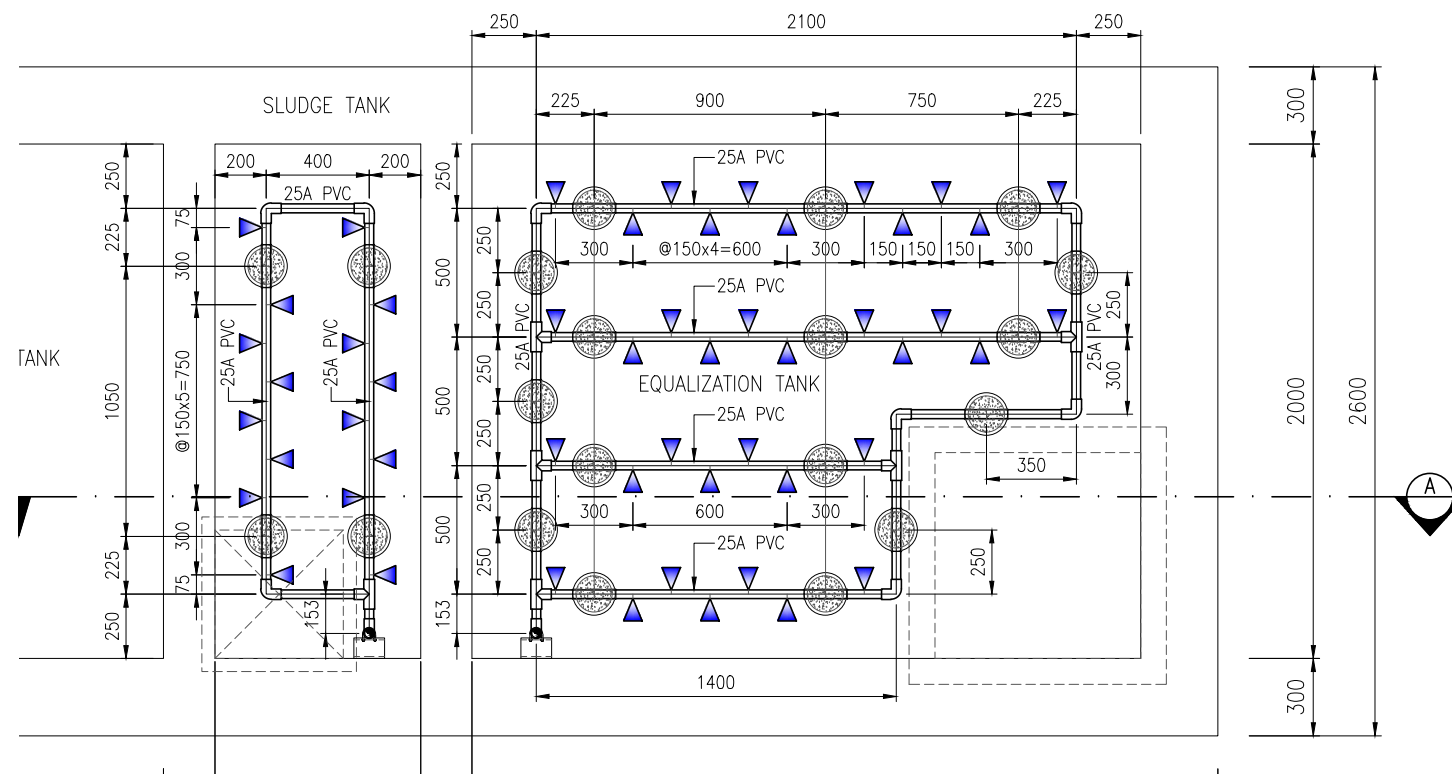


TOP PLAN  
1:15

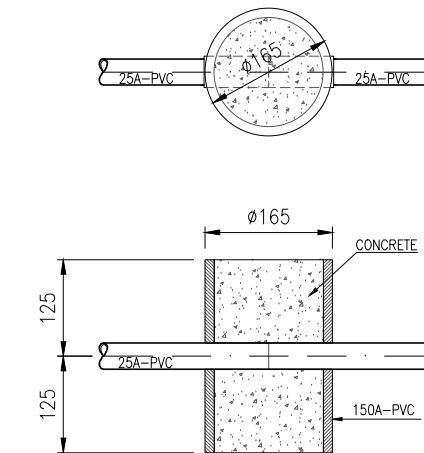

DETAIL SUPPORT AIR PIPE 25A (20 SETS)  
1:50A1

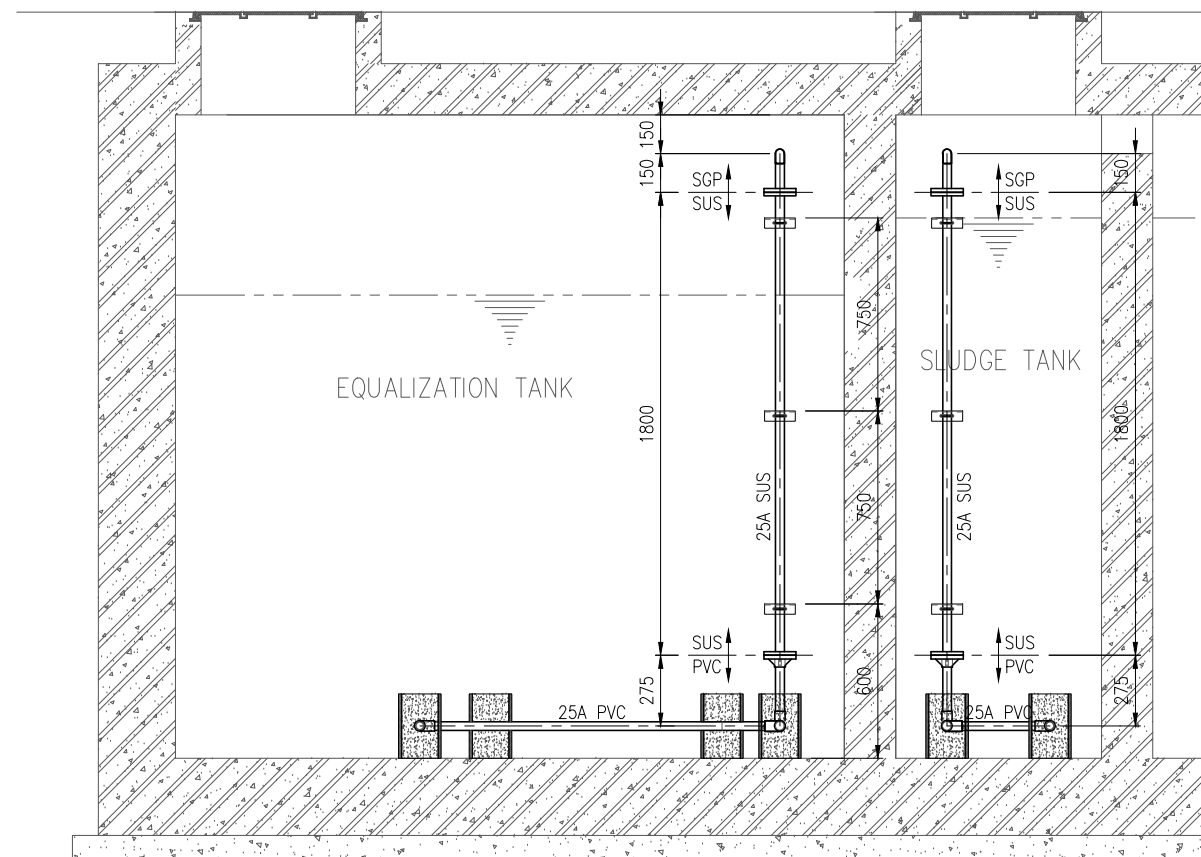

SECTION A  
1:15

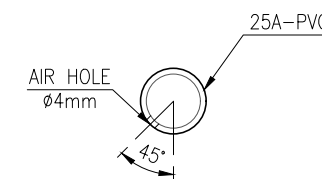

TYPICAL HOLE AIR PIPE  
1:20A1

AS BUILT DRAWING

16-Nov-2017

GOSHU KOHSAN(VIETNAM)CO.,LTD.  
PLANT DEPARTMENT

| Rev. | Date. | Content | Request BY |
|------|-------|---------|------------|
|      |       |         |            |
|      |       |         |            |
|      |       |         |            |

Messrs.

GREEN ONE UN HOUSE

Project Name.

DOMESTIC WASTEWATER TREATMENT PLANT



GOSHU KOHSAN (VIETNAM) CO.,LTD.

HANOI HEAD OFFICE  
LOT P1, THANG LONG IP, DONG ANH DIST,  
HANOI, VIETNAM.  
<http://www.goshukohsan.com.vn>

Designer

D.G.LONG

Dwg. Date

03/08/2017

Check.

T.X.THANH

Issued Date

16/11/2017

Approved.

NG.VY

Drawn By.

C.V.HOA

Item.

DOMESTIC WASTEWATER TREATMENT PLANT

Rev. No.

00

Dwg. Title.

AIR PIPE EQUALIZATION TANK & SLUDGE TANK




Scale

NONE

Job No.

Dwg. Code


DWWTP-ME-305

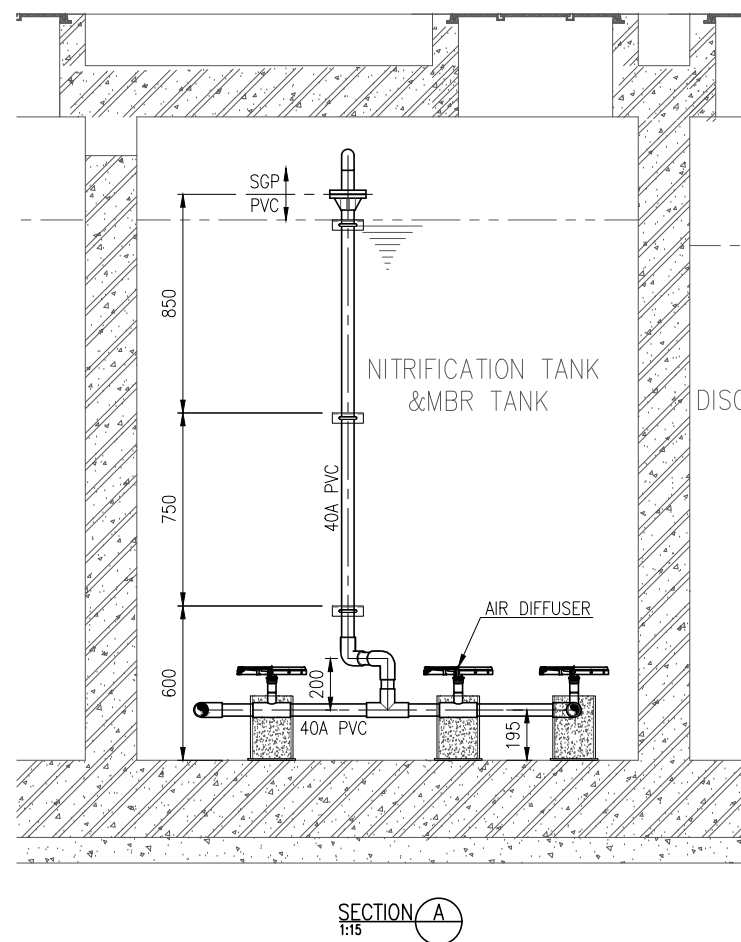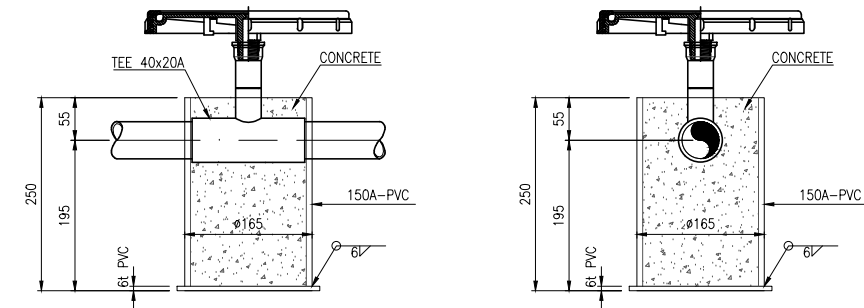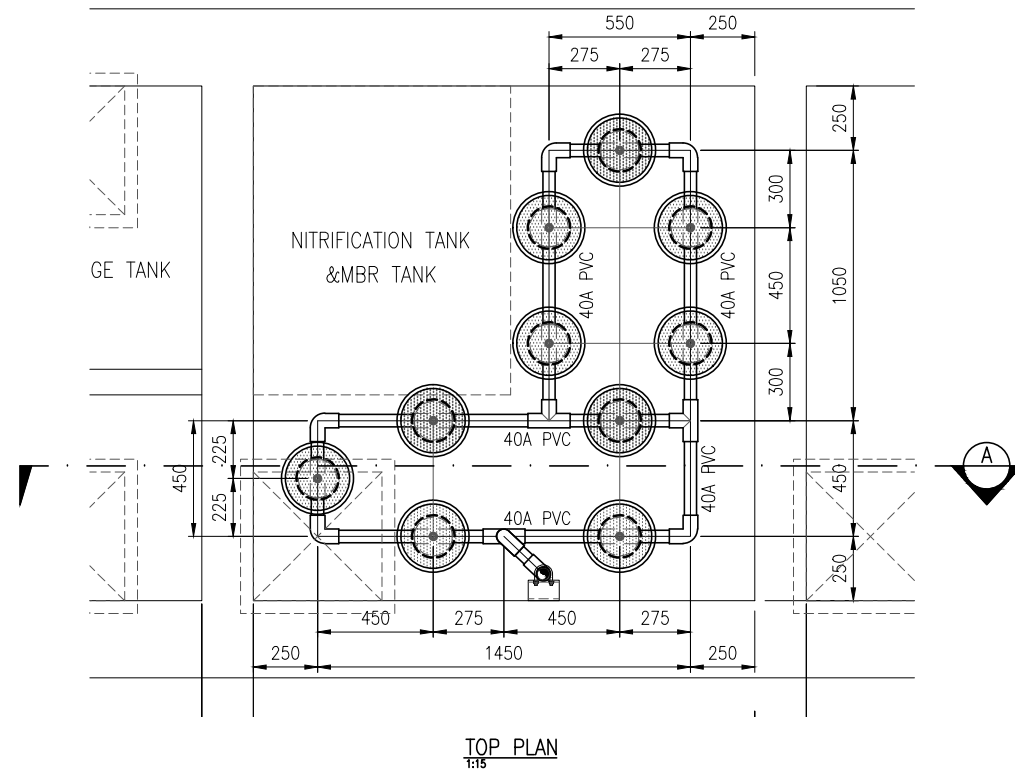


AS BUILT DRAWING

16-Nov-2017


GOSHU KOHSAN(VIETNAM)CO.,LTD.  
PLANT DEPARTMENT

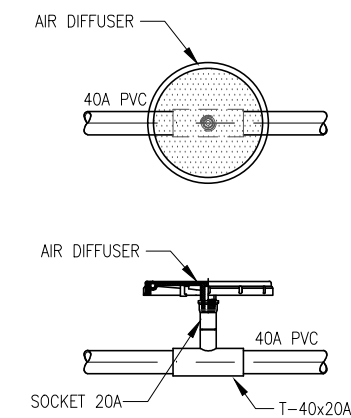


|                 |      |       |         |            |         |                    |                                                                                                                                                                                                                                                                                            |           |           |             |            |             |                                     |           |              |
|-----------------|------|-------|---------|------------|---------|--------------------|--------------------------------------------------------------------------------------------------------------------------------------------------------------------------------------------------------------------------------------------------------------------------------------------|-----------|-----------|-------------|------------|-------------|-------------------------------------|-----------|--------------|
| Revision Record | Rev. | Date. | Content | Request By | Messrs. | Project Name.      |  <b>GOSHU KOHSAN (VIETNAM) CO.,LTD.</b><br>HANOI HEAD OFFICE<br>LOT P1, THANG LONG IP, DONG ANH DIST,<br>HANOI, VIETNAM.<br><a href="http://www.goshukohsan.com.vn">http://www.goshukohsan.com.vn</a> | Designer  | D.G.LONG  | Dwg. Date   | 03/08/2017 | Item.       | DOMESTIC WASTEWATER TREATMENT PLANT | Rev. No.  | 00           |
|                 |      |       |         |            |         | GREEN ONE UN HOUSE |                                                                                                                                                                                                                                                                                            | Check.    | T.X.THANH | Issued Date | 16/11/2017 | Dwg. Title. | AIR PIPE NITRIFICATION TANK         | Scale     | NONE         |
|                 |      |       |         |            |         |                    |                                                                                                                                                                                                                                                                                            | Approved. | NG.VY     | Drawn By.   | C.V.HOA    | Job No.     |                                     | Dwg. Code | DWWTP-ME-306 |

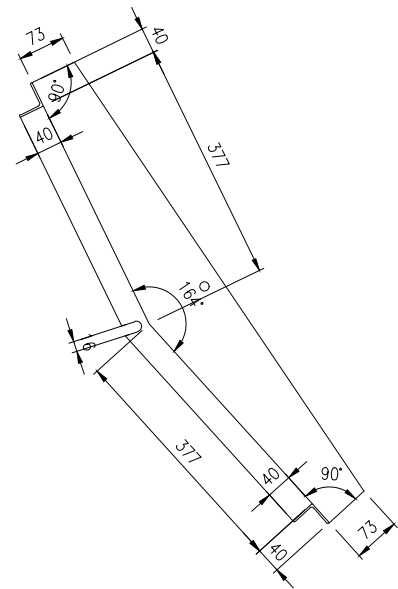


FINE SCREEN  
1:6

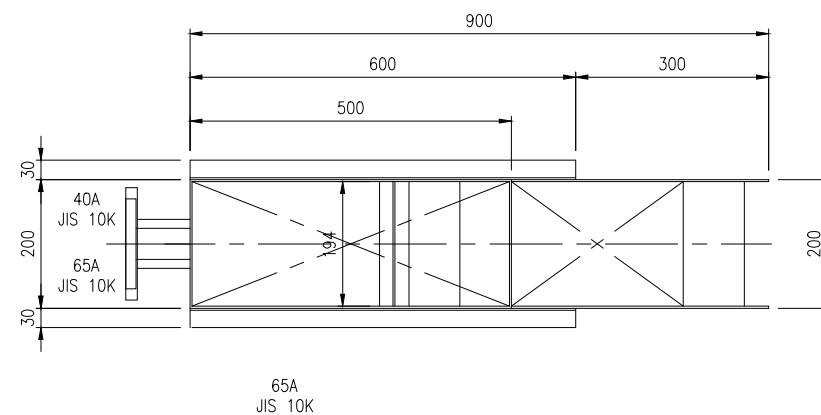


TOP VIEW  
1:6

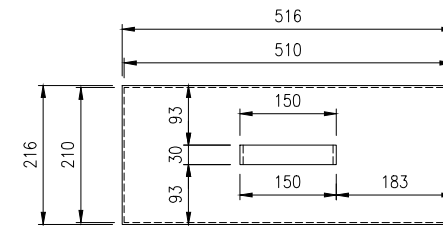


DETAIL 1  
1:6

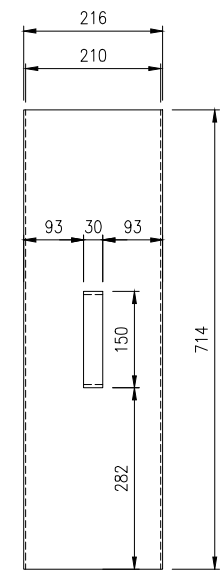


DETAIL 2  
1:6

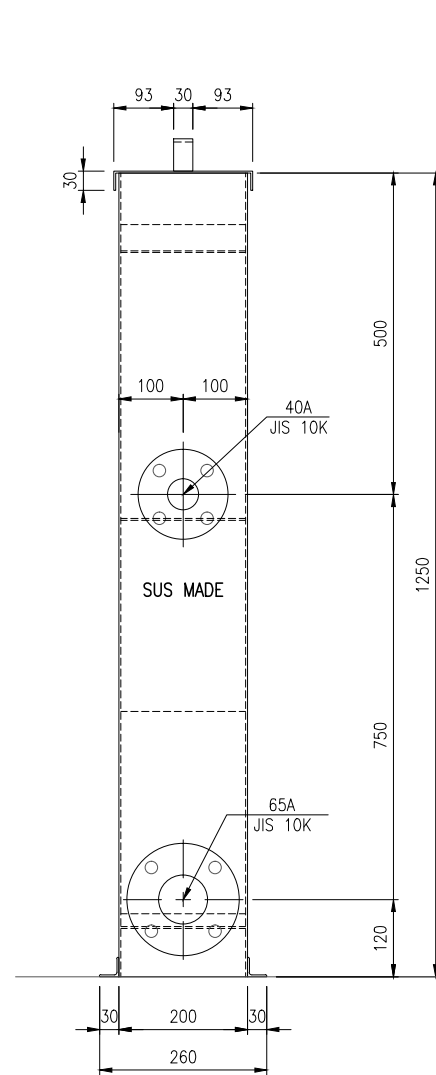

LEFT VIEW  
1:6

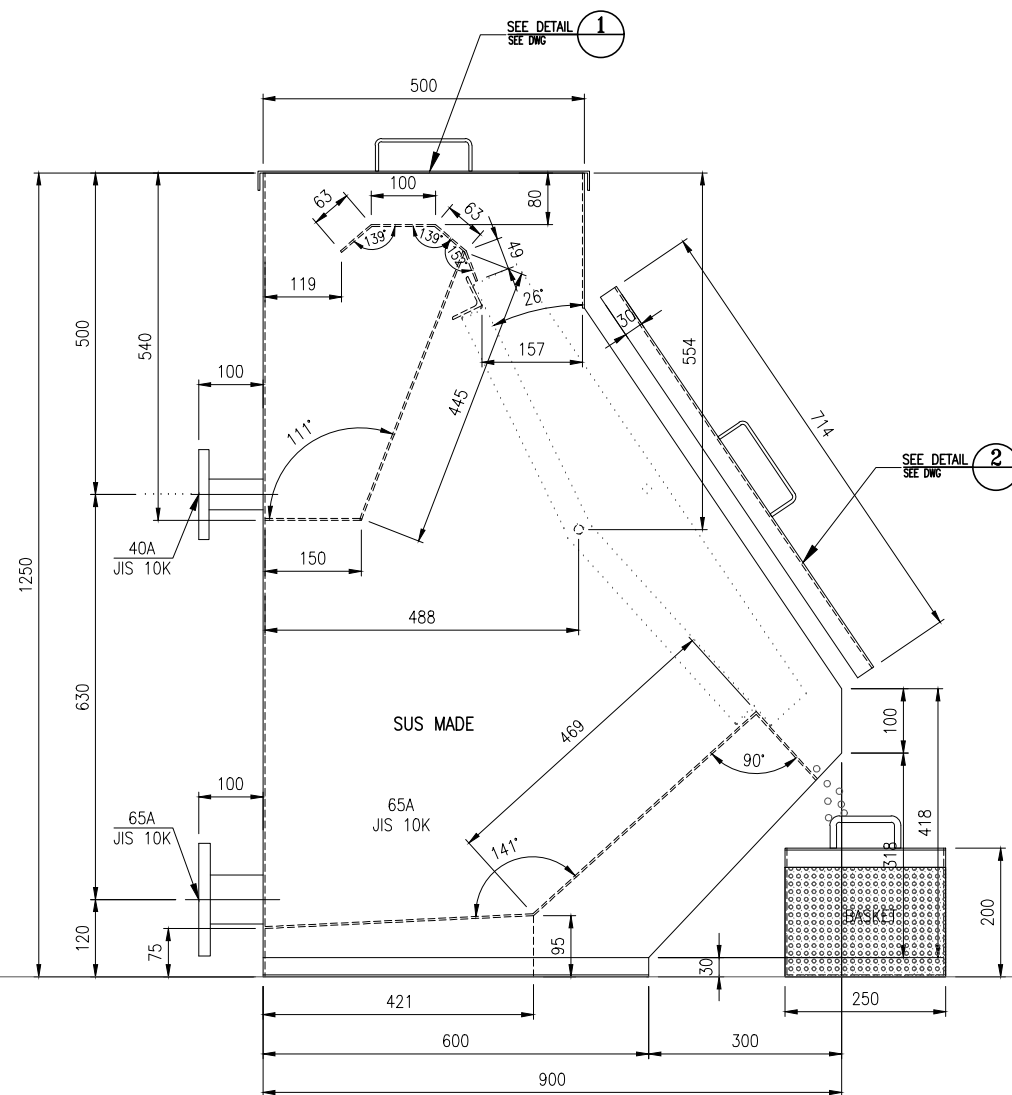


FRONT VIEW  
1:6

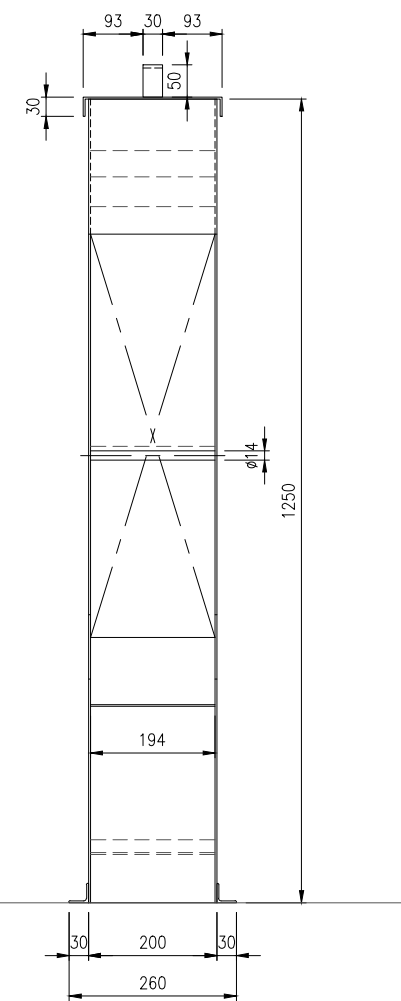


RIGHT VIEW  
1:6

AS BUILT DRAWING  
16-Nov-2017  
GOSHU KOHSAN(VIETNAM)CO.,LTD.  
PLANT DEPARTMENT

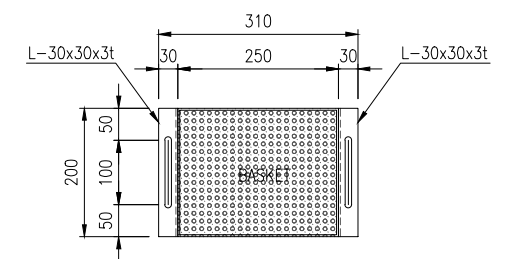


TOP VIEW

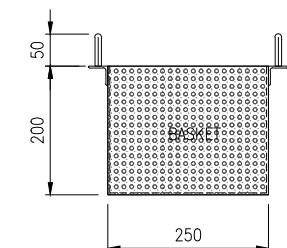


FRONT VIEW

BASKET DETAIL  
1:6


|                 |      |       |         |            |                    |                                     |                                                                                                                                                                                                                                                                                            |           |           |             |            |             |                                     |           |             |
|-----------------|------|-------|---------|------------|--------------------|-------------------------------------|--------------------------------------------------------------------------------------------------------------------------------------------------------------------------------------------------------------------------------------------------------------------------------------------|-----------|-----------|-------------|------------|-------------|-------------------------------------|-----------|-------------|
| Revision Record | Rev. | Date. | Content | Request By | Messrs.            | Project Name.                       |  <b>GOSHU KOHSAN (VIETNAM) CO.,LTD.</b><br>HANOI HEAD OFFICE<br>LOT P1, THANG LONG IP, DONG ANH DIST,<br>HANOI, VIETNAM.<br><a href="http://www.goshukohsan.com.vn">http://www.goshukohsan.com.vn</a> | Designer  | D.G.LONG  | Dwg. Date   | 01/08/2017 | Item.       | DOMESTIC WASTEWATER TREATMENT PLANT | Rev. No.  | 01          |
|                 |      |       |         |            | GREEN ONE UN HOUSE | DOMESTIC WASTEWATER TREATMENT PLANT |                                                                                                                                                                                                                                                                                            | Check.    | T.X.THANH | Issued Date | 16/11/2017 | Dwg. Title. | MANUAL FINE SCREEN                  | Scale     | NONE        |
|                 |      |       |         |            |                    |                                     |                                                                                                                                                                                                                                                                                            | Approved. | NG.VY     | Drawn By.   | C.V.HOA    | Job No.     |                                     | Dwg. Code | DWWT-ME-401 |
|                 |      |       |         |            |                    |                                     |                                                                                                                                                                                                                                                                                            |           |           |             |            |             |                                     |           |             |

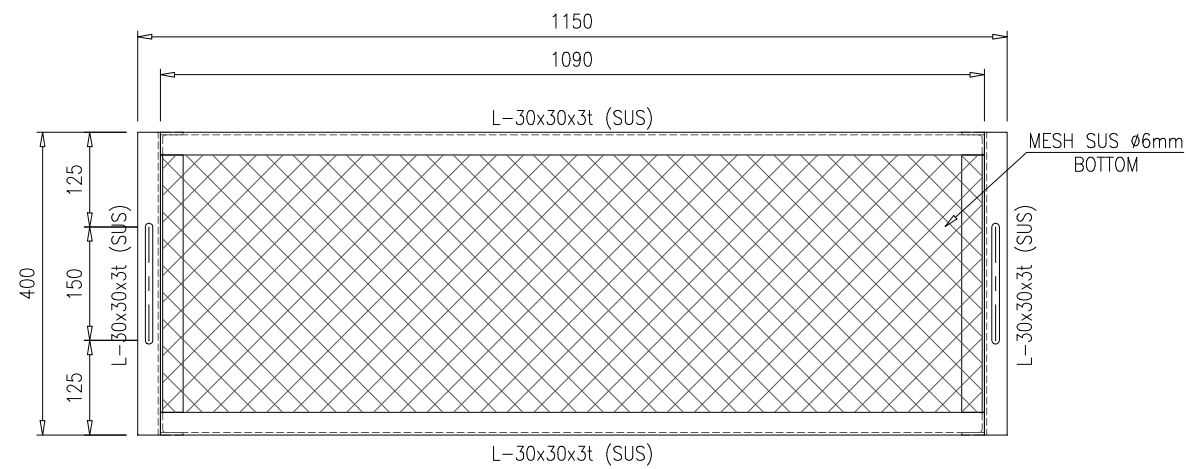


TOP VIEW  
1:5

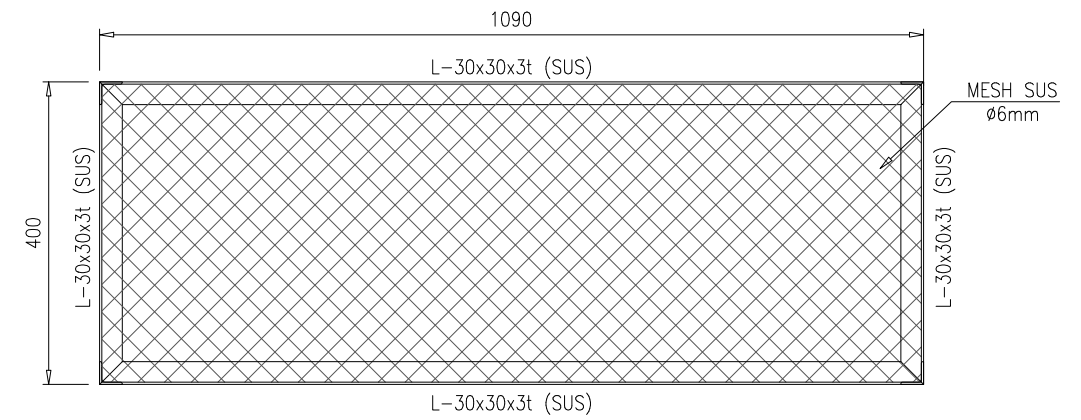

BOTTOM VIEW  
1:5

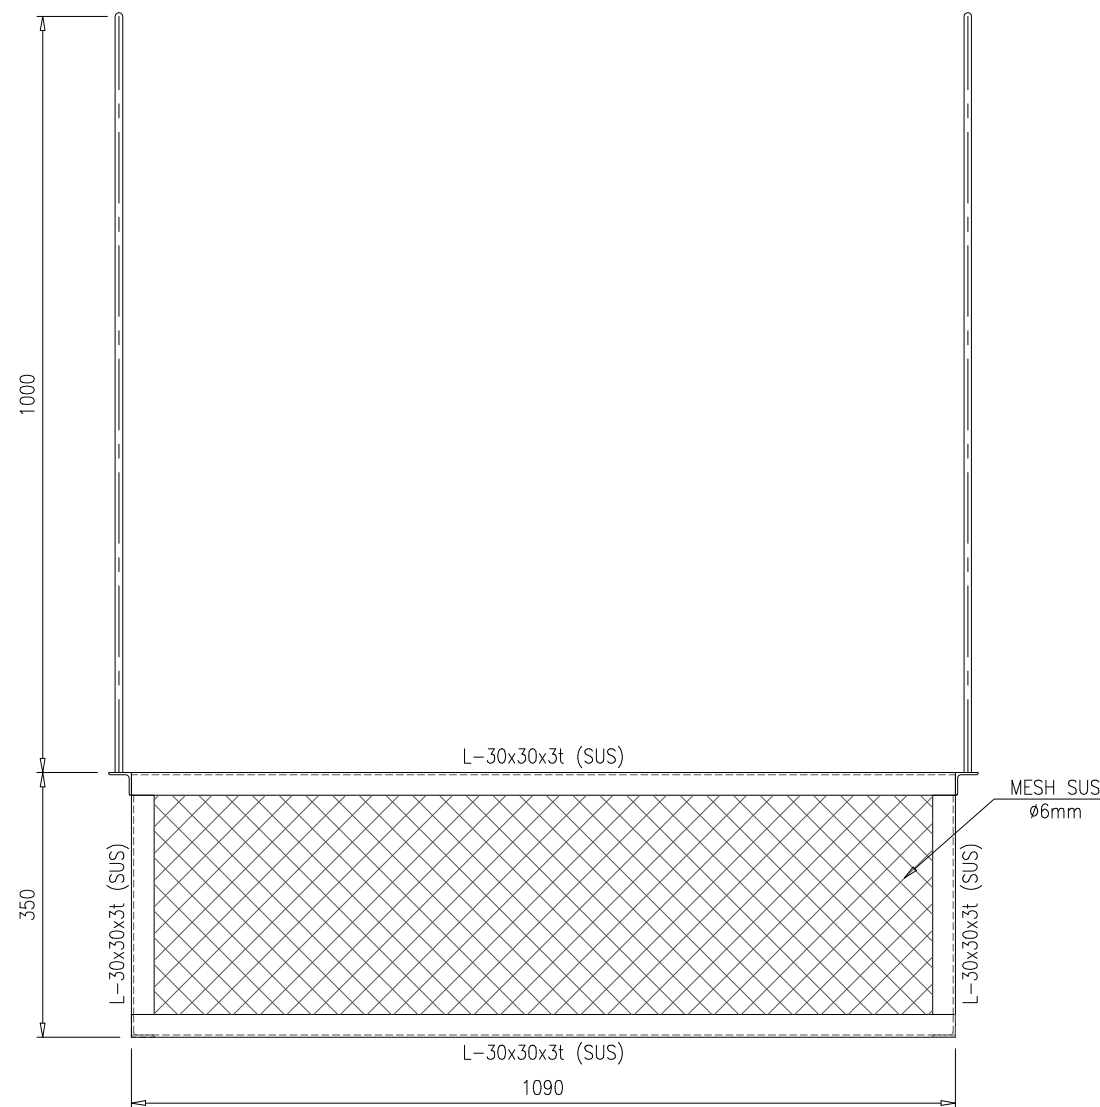

FRONT VIEW  
1:5

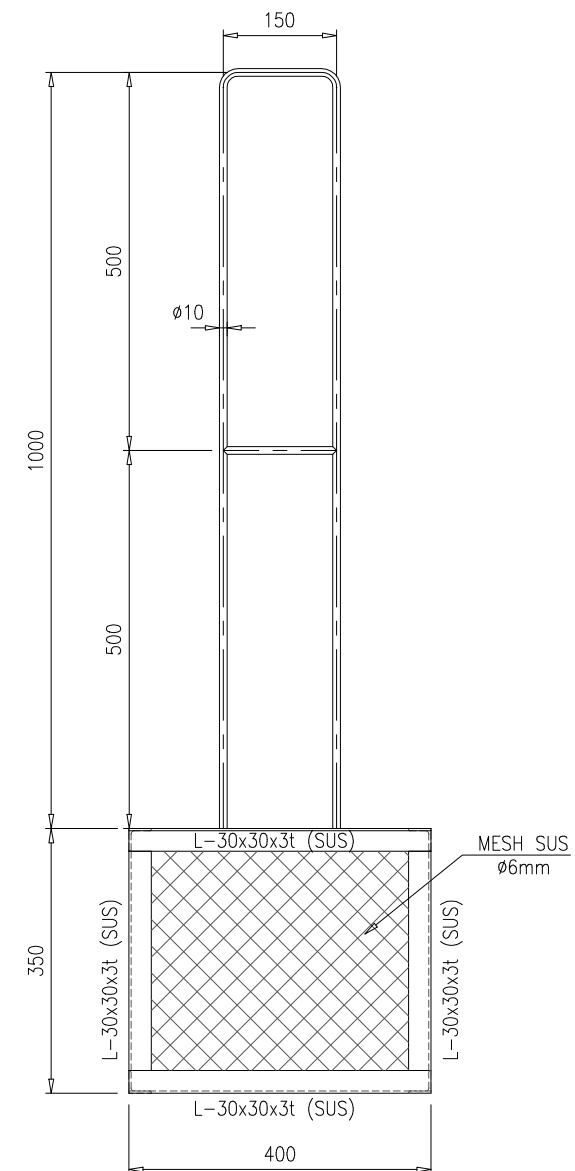

RIGHT VIEW  
1:5

AS BUILT DRAWING

16-Nov-2017

GOSHU KOHSAN (VIET NAM) CO.,LTD.  
PLANT DEPARTMENT

Messrs.

GREEN ONE UN HOUSE

Project Name.

DOMESTIC WASTEWATER TREATMENT PLANT



GOSHU KOHSAN (VIETNAM) CO.,LTD.  
HANOI HEAD OFFICE  
LOT P1, THANG LONG IP, DONG ANH DIST,  
HANOI, VIETNAM.  
<http://www.goshukohsan.com.vn>

Designer

D.G.LONG

Dwg. Date

23/08/2017

Check.

T.X.THANH

Issued Date

16/11/2017

Approved.

N.VY

Drawn By.

C.V.HOA

Item.

DOMESTIC WASTEWATER TREATMENT PLANT

Dwg. Title.

BASKET DETAIL

Job No.

—

Dwg. Code

DWWTP-ME-402

Rev. No.

00



Scale

NONE




AS BUILT DRAWING

16-Nov-2017


GOSHU KOHSAN (VIET NAM) CO.,LTD.  
PLANT DEPARTMENT

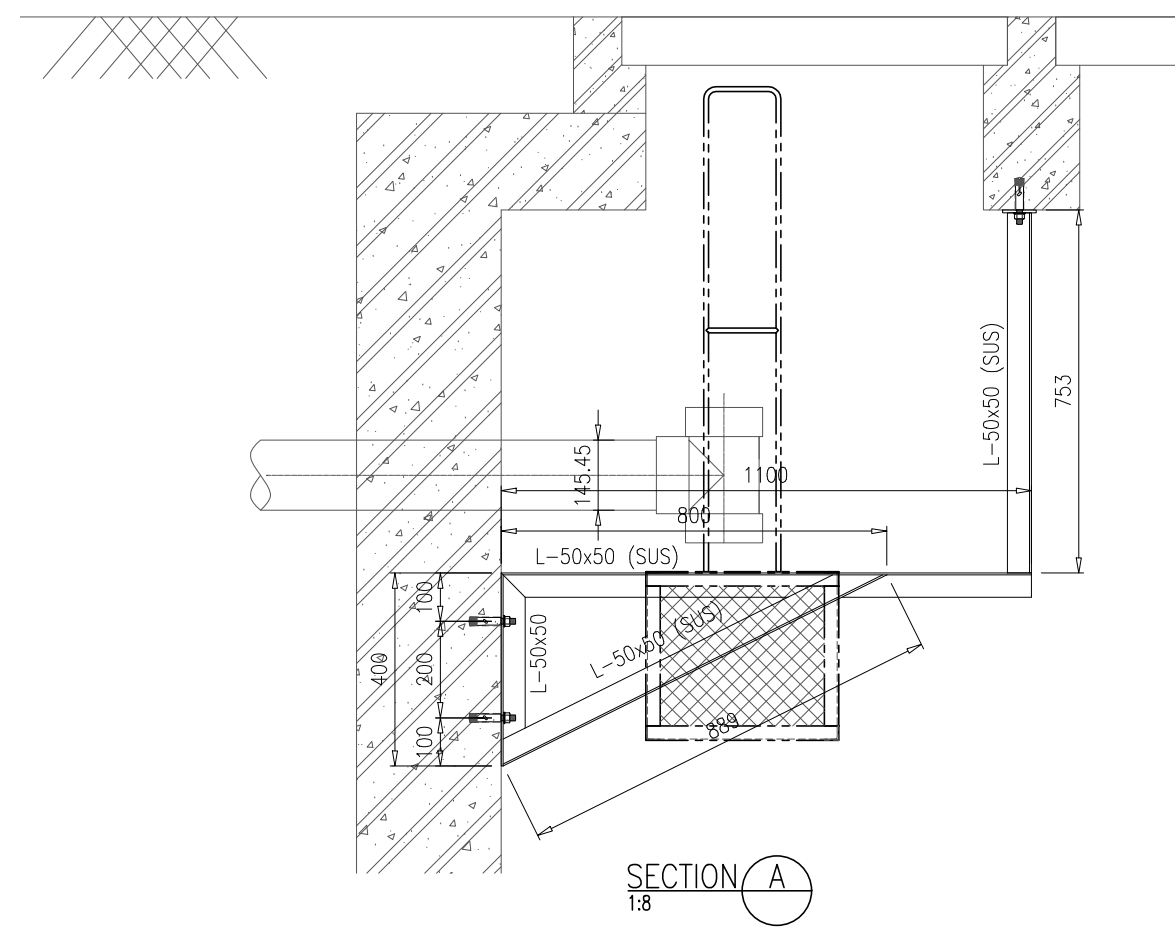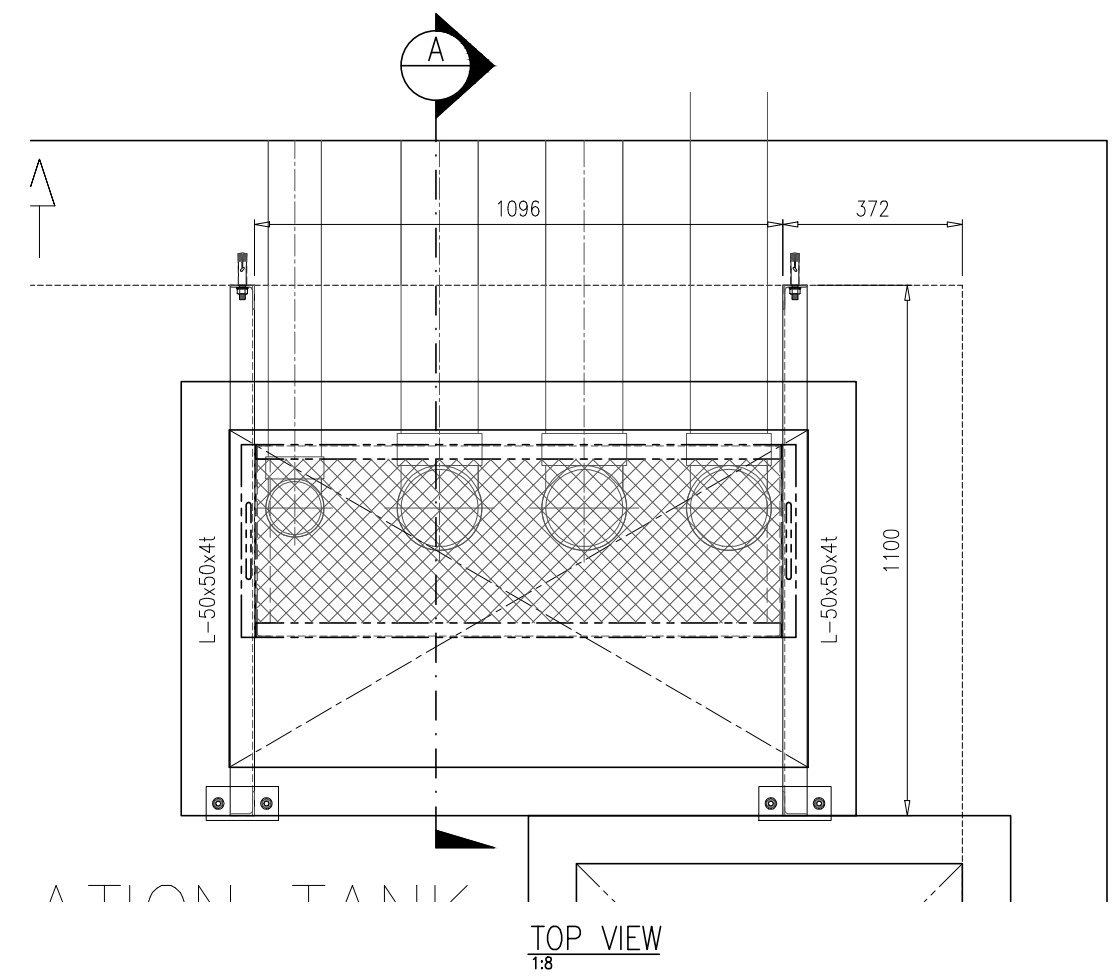

|                 |      |       |         |  |  |                    |                                     |                                                                                                                                                                                                                                                                                                    |            |           |             |            |             |                                     |           |             |      |
|-----------------|------|-------|---------|--|--|--------------------|-------------------------------------|----------------------------------------------------------------------------------------------------------------------------------------------------------------------------------------------------------------------------------------------------------------------------------------------------|------------|-----------|-------------|------------|-------------|-------------------------------------|-----------|-------------|------|
| Revision Record |      |       |         |  |  | Messrs.            | Project Name.                       |  <div>GOSHU KOHSAN (VIETNAM) CO.,LTD.<br/>HANOI HEAD OFFICE<br/>LOT P1, THANG LONG IP, DONG ANH DIST,<br/>HANOI, VIETNAM.<br/><a href="http://www.goshukohsan.com.vn">http://www.goshukohsan.com.vn</a></div> | Designer   | D.G.LONG  | Dwg. Date   | 23/08/2017 | Item.       | DOMESTIC WASTEWATER TREATMENT PLANT |           | Rev. No.    | 00   |
|                 |      |       |         |  |  | GREEN ONE UN HOUSE | DOMESTIC WASTEWATER TREATMENT PLANT |                                                                                                                                                                                                                                                                                                    | Check.     | T.X.THANH | Issued Date | 16/11/2017 | Dwg. Title. | BASKET INSTALLATION                 |           | Scale       | NONE |
|                 |      |       |         |  |  |                    |                                     |                                                                                                                                                                                                                                                                                                    | Approved.  | N.VY      | Drawn By.   | C.V.HOA    | Job No.     | -                                   | Dwg. Code | DWWT-PE-403 |      |
|                 | Rev. | Date. | Content |  |  |                    |                                     |                                                                                                                                                                                                                                                                                                    | Request BY |           |             |            |             |                                     |           |             |      |

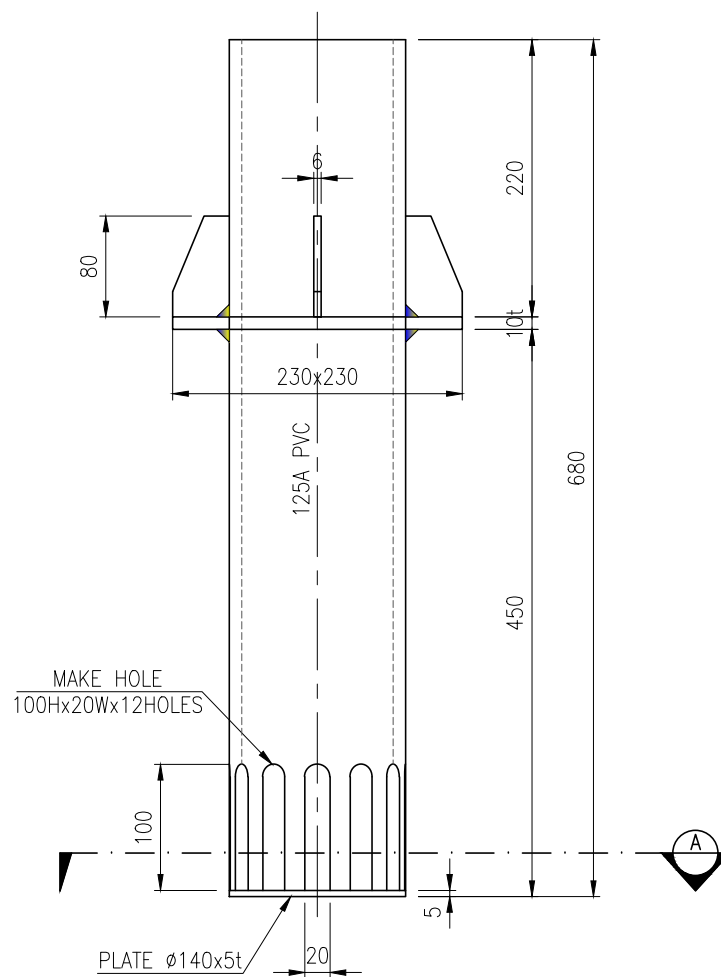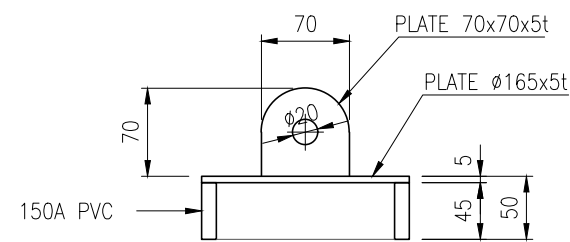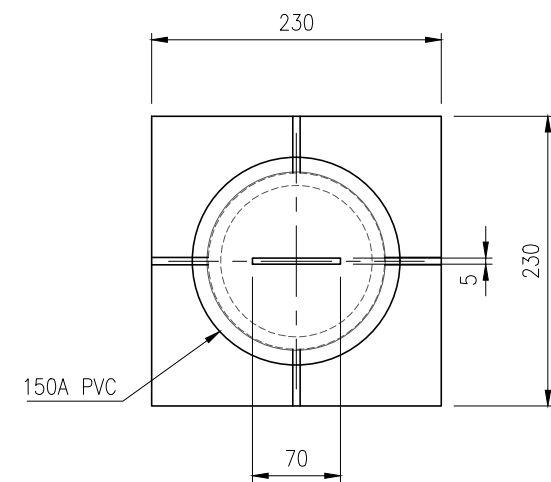

DETAIL CHLORINATOR BOX  
1:3

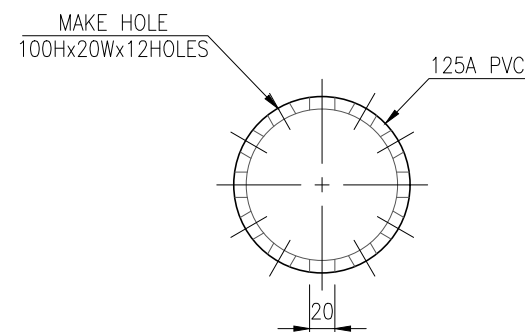


SECTION A  
1:3


AS BUILT DRAWING

16-Nov-2017

GOSHU KOHSAN (VIET NAM) CO.,LTD.  
PLANT DEPARTMENT

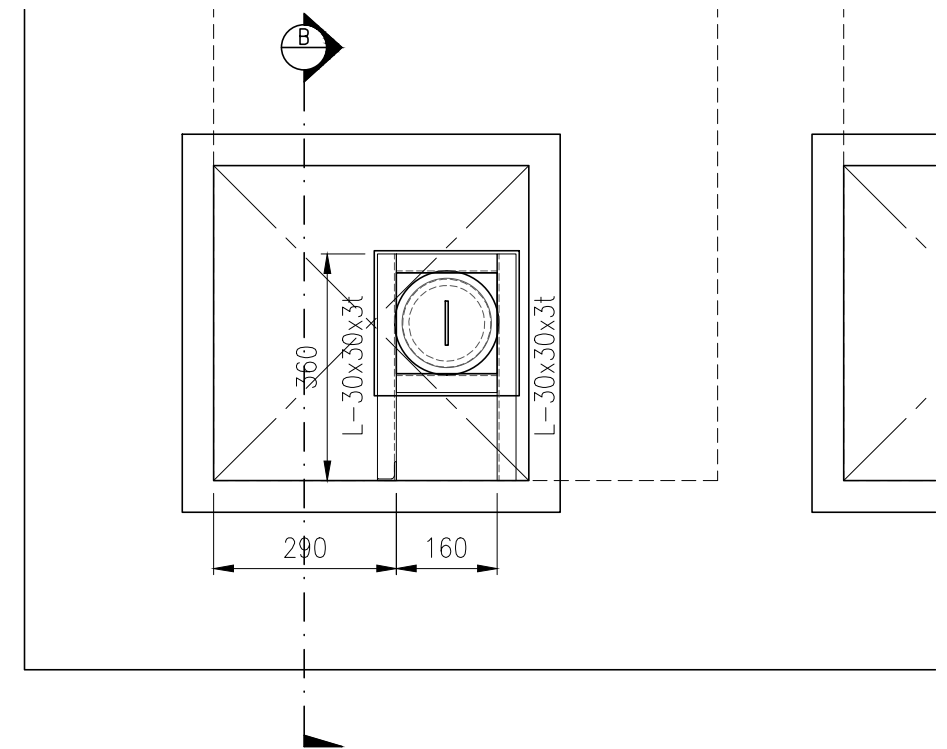

CHLORINATOR BOX INSTALLATION TOP VIEW  
1:6

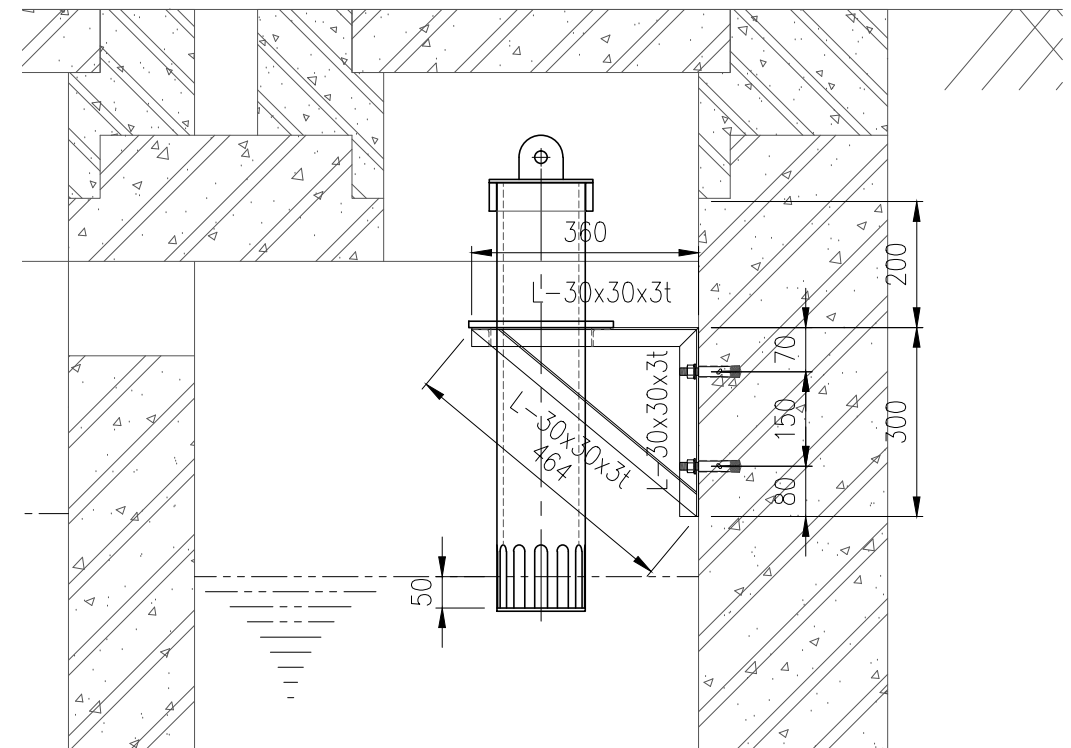

SECTION B  
1:6

|                 |      |-----------------|------|-------|--|---------|---------|--------------------|---------------|-------------------------------------|--------------------------------------------------------------------------------------------------|-----------------------------------------------------------------------------------------------------------------------------------------------------------------------------------------------|-----------|-----------|-------------|------------|-------------|-------------------------------------|-----------|--------------|--|--|--|--|--|
| Revision Record |      |       |  |         | Messrs. | GREEN ONE UN HOUSE | Project Name. | DOMESTIC WASTEWATER TREATMENT PLANT | <br>VIETNAM | GOSHU KOHSAN (VIETNAM) CO.,LTD.<br>HANOI HEAD OFFICE<br>LOT P1, THANG LONG IP, DONG ANH DIST,<br>HANOI, VIETNAM.<br><a href="http://www.goshukohsan.com.vn">http://www.goshukohsan.com.vn</a> | Designer  | D.G.LONG  | Dwg. Date   | 23/08/2017 | Item.       | DOMESTIC WASTEWATER TREATMENT PLANT | Rev. No.  | 00           |  |  |  |  |  |
|                 |      |                 |      |                 |      |                 |      |                 | Rev. | Date. |  | Content |         |                    |               |                                     |                                                                                                  |                                                                                                                                                                                               | Check.    | T.X.THANH | Issued Date | 16/11/2017 | Dwg. Title. | CHLORINATOR BOX                     | Scale     | NONE         |  |  |  |  |  |
|                 |      |       |  |         |         |                    |               |                                     |                                                                                                  |                                                                                                                                                                                               | Approved. | N.VY      | Drawn By.   | C.V.HOA    | Job No.     | -                                   | Dwg. Code | DWWTP-ME-404 |  |  |  |  |  |

