




SECTION THRU KITCHEN WORKTOP

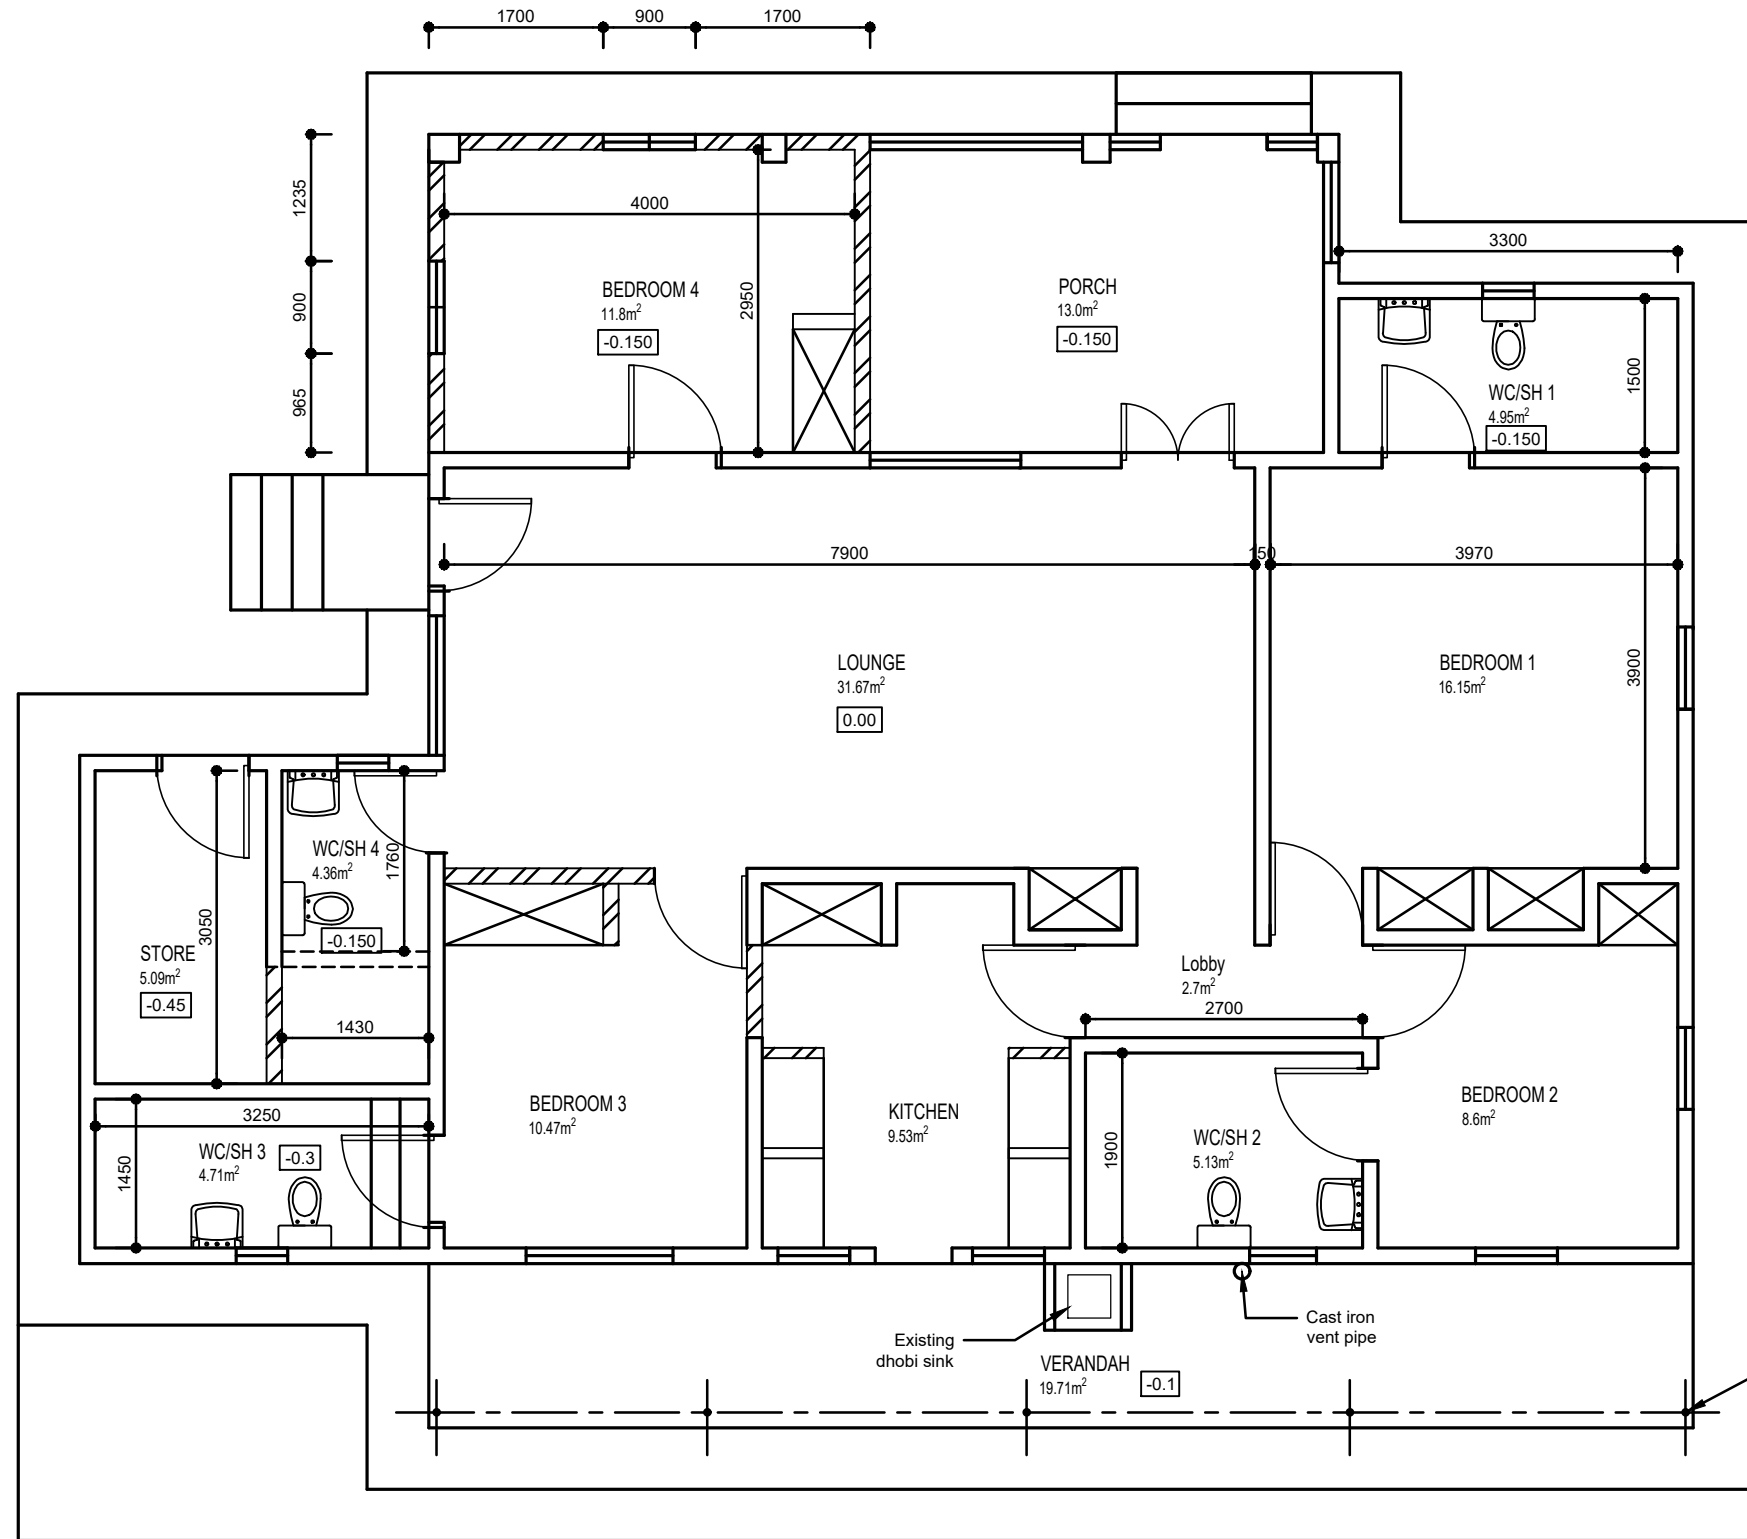

KEY
 [---] Walls to be demolished
 [---] Walls to be constructed

TENDER DRAWING

| | | | | | | |
|---|--|--|---|------------------------------|--|-------------------------|
|  | UNITED NATIONS DEVELOPMENT PROGRAMME Juba - South Sudan | DRAWING TITLE: Naivasha Residence - Housing Units | SHEET CONTENT: As-built foundation Layout Plan | SCALE: 1:100, 1:75. | | |
| | | DRAWING NAME: Renovation of house 3.dwg | | DATE: Oct. 2018 | | |
|  | | DESIGN BY: UNDP | | CONTRACT No: | | DRAWING No: A-01 |
| | | DRAWN BY: Okungulu | | APPROVED FOR IMPLEMENTATION: | | |