




FRONT ELEVATION



SIDE ELEVATION

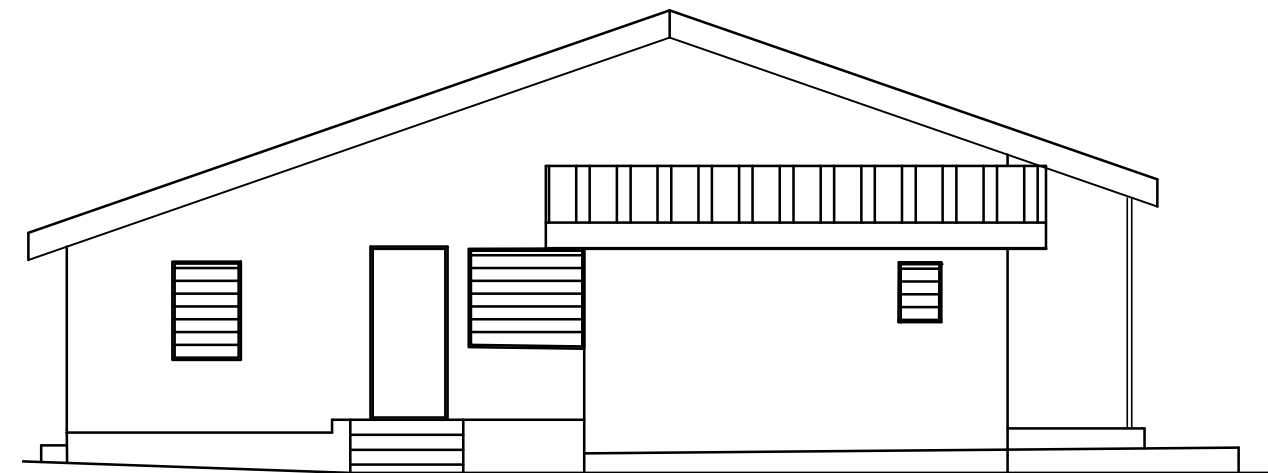

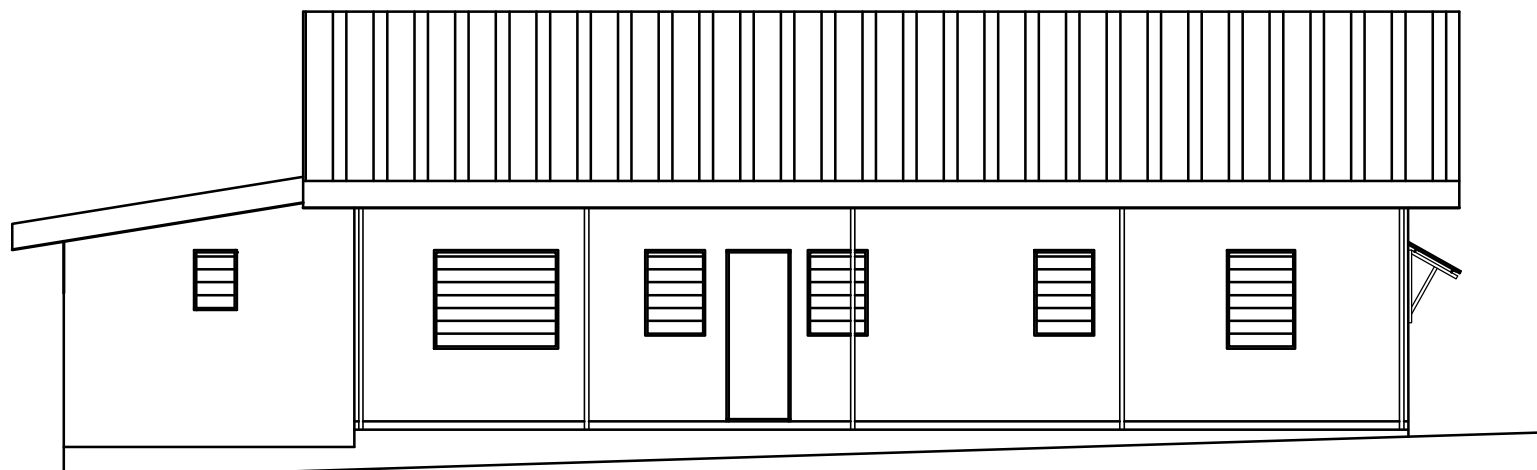

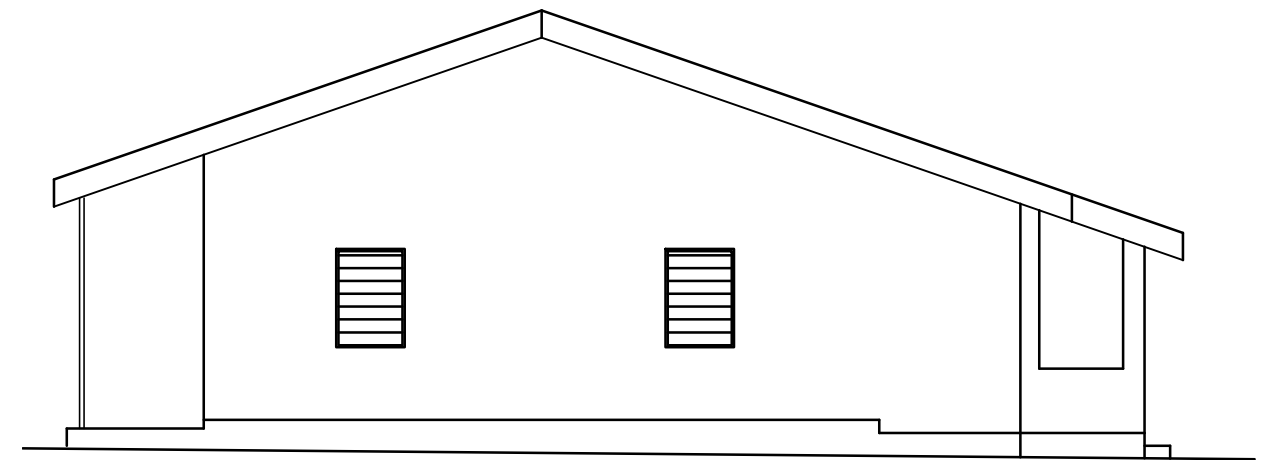REAR ELEVATION



SIDE ELEVATION

TENDER DRAWING

	UNITED NATIONS DEVELOPMENT PROGRAMME Juba - South Sudan	DRAWING TITLE: Naivasha Residence - Housing Units	SHEET CONTENT: As-built elevations	SCALE: 1:100.		
		DRAWING NAME: Renovation of house 3.dwg		DATE: Oct. 2018		
		DESIGN BY: UNDP		CONTRACT No:		DRAWING No:
		DRAWN BY: Okungulu		APPROVED FOR IMPLEMENTATION:		A-02