




FRONT ELEVATION



SIDE ELEVATION

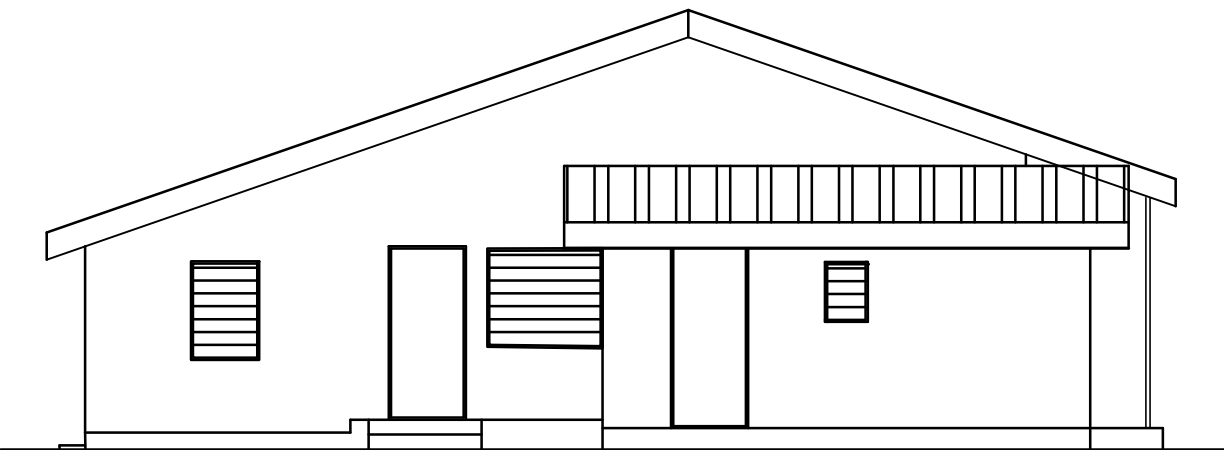

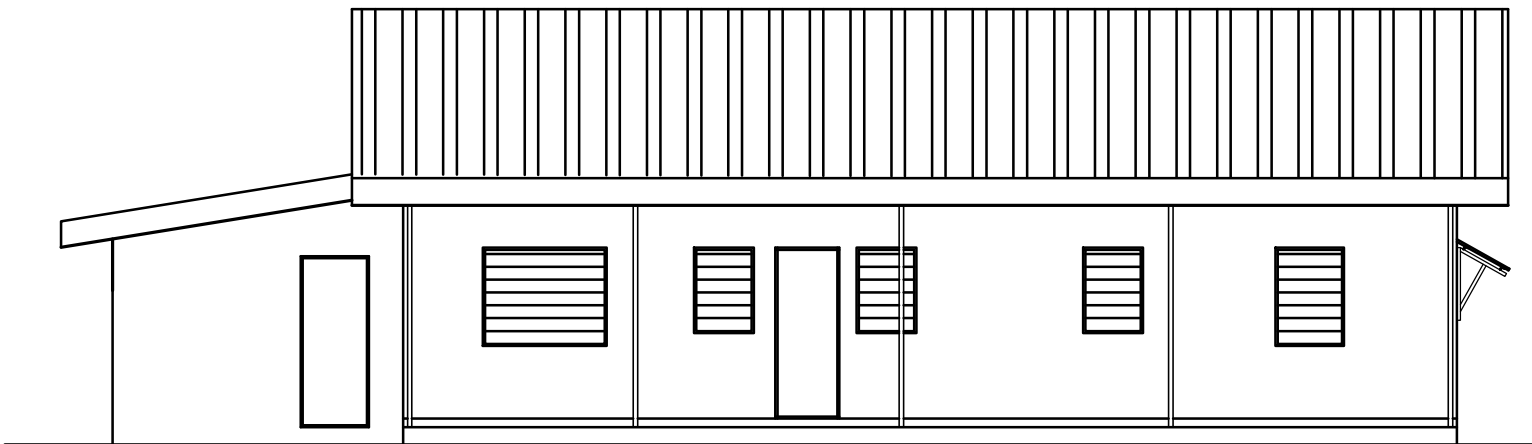

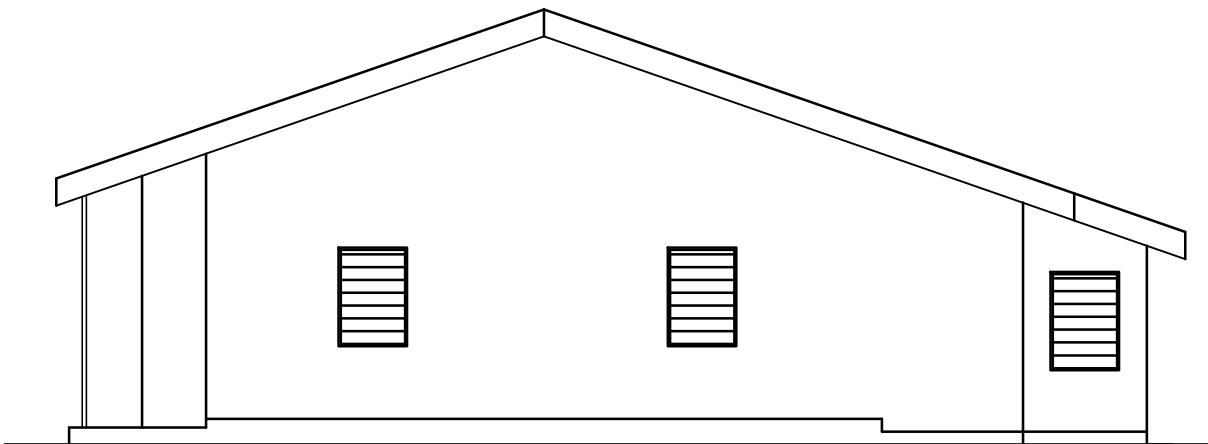REAR ELEVATION



SIDE ELEVATION

TENDER DRAWING

|                                                                                    |                                                                                    |                                                      |                                       |                              |  |             |
|------------------------------------------------------------------------------------|------------------------------------------------------------------------------------|------------------------------------------------------|---------------------------------------|------------------------------|--|-------------|
|  | UNITED NATIONS DEVELOPMENT PROGRAMME<br>Juba - South Sudan                         | DRAWING TITLE:<br>Naivasha Residence - Housing Units | SHEET CONTENT:<br>As-built elevations | SCALE:<br>1:100.             |  |             |
|                                                                                    |                                                                                    | DRAWING NAME:<br>Renovation of house 5.dwg           |                                       | DATE:<br>Oct. 2018           |  |             |
|                                                                                    |  | DESIGN BY:<br>UNDP                                   |                                       | CONTRACT No:                 |  | DRAWING No: |
|                                                                                    |                                                                                    | DRAWN BY:<br>Okungulu                                |                                       | APPROVED FOR IMPLEMENTATION: |  | A-02        |