

TAKEOFF SHEET**Project :- Office Space Renovation**

Description	Times	Dimensions	Sum	Description	Times	Dimensions	Sum
Office Space 1				Office Space 2			
Paint				Paint			
Internal Wall		0.77		Internal Wall		4.47	
		2.61	2.01			2.61	11.67
		4.20				3.48	
		2.61	10.96			2.61	9.08
		0.58				0.46	
		2.61	1.51			2.61	1.20
		3.79				3.49	
		2.61	9.89			0.98	3.42
		0.33				0.92	
		2.61	0.86			2.61	2.40
		0.78				Deduction	
		2.61	2.04			1.14	
		3.37				0.94	1.07
		0.98	3.30			Total	26.70
		0.24		PVC Tiles			
		2.61	0.63	Floor Tiles		Total	13.94
		0.39		Light Lamps		Total	8.00
		2.61	1.02				
		0.48					
		2.61	1.25				
		Total	33.47				
PVC Tiles							
Floor Tiles		Total	19.59				
Light Lamps		Total	8.00				
Pool Office 1							
Paint							
Internal Wall		4.61					
		2.61	12.03				
		4.56					
		2.61	11.90				
		4.7					
		2.61	12.27				
	2	1.02					
		2.61	5.32				
		0.33					
		4.38	1.45				
	2	0.33					
		3.9	2.57				
		Deduction					
		1.14					
		0.94	1.0716				
		0.86					
		2.10	1.806				
		Total	42.67				
PVC Tiles							
Floor Tiles		Total	58.16				
Light Lamps		Total	24.00				
Renovation of wooden door		Total	1.00				


Description	Times	Dimensions	Sum	Description	Times	Dimensions	Sum
Pool Office 2				Meeting Hall 1			
Paint				Paint			
Internal Wall		3.95		Internal Wall		0.28	
		2.61	10.31			2.61	0.73
		0.21				3.89	
		2.61	2.82			0.98	4.87
		3.86				0.33	
		0.98	3.78			3.89	1.28
		0.6				0.20	
		2.61	1.57			2.61	0.52
		2.19				3.95	
		0.98	2.15			2.61	10.31
		0.33				0.57	
		3.86	1.27			2.61	1.49
		0.33				Deduction	
		2.19	0.72			0.96	
		0.29				2.10	2.02
		2.61	0.76			Total	17.19
		4.12		PVC Tiles			
		2.61	10.75	Floor Tiles		Total	18.06
		2.18		Light Lamp		Total	8.00
		2.43	5.30	Meeting Hall 2			
		0.4		Paint			
		2.18	0.87	Internal Wall		3.51	
		1.02				2.54	8.9154
		2.61	2.66			0.07	
		0.42				2.54	0.1651
		2.61	1.10			15.45	
		0.42				2.54	39.243
		2.61	1.10			5.07	
		Deduction				2.54	12.8778
		0.96				1.25	
		2.10	2.02			2.54	3.175
		0.8				0.36	
		2.1	1.68			14.4	5.184
		Total	41.46		4	0.33	
PVC Tiles						2.34	3.0888
Floor Tiles		Total	28.36			Total	72.65
Light Lamp		Total	16.00	External Wall	4	0.33	
External Grade Beam							
(for Cementations							
Paint		0.29				2.60	3.432
		18.80	5.452		5	3.40	
		0.19				0.36	6.12
		15.65	2.9735			1.54	
		Total	8.43			2.60	4.004
						0.20	
						2.60	0.52
						Total	14.08
				Light Fixture		Total	3.00

Description	Times	Dimensions	Sum	Description	Times	Dimensions	Sum
Men's Toilet 1				Women's Toilet 1			
Paint				Paint			
Internal Wall		2.34		Internal Wall		3.91	
		0.98	2.29			0.82	3.21
		1.20				0.15	
		0.98	1.18			0.82	0.12
		1.23				4.04	
		2.61	3.21			0.82	3.31
		1.56				0.33	
		0.98	1.53			1.84	0.61
		1.96				1.86	
		0.98	1.92			0.82	1.53
		1.78				Deduction	
		0.98	1.74			0.90	
		1.61				0.82	0.74
		0.98	1.58			Total	8.04
				Partition wall b/n the toilet seat		Total	1.00
		0.36		Toilet Seats		Total	2.00
		0.98	0.35	Hand Wash Basin		Total	1.00
		0.33		Soap Holder		Total	1.00
		3.87	1.28	Soft Holder		Total	2.00
		0.37		Towel Holder		Total	1.00
		0.98	0.36	Mirror		Total	2.00
		Deduction		Dryer		Total	1.00
		0.88		Light Fixtures		Total	3.00
		2.10	1.85	Door Handrail		Total	1.00
		Total	13.60				
Toilet Seats		Total	2.00	Men's Toilet 2			
Hand Wash Basin		Total	1.00	Paint			
Soap Holder		Total	1.00	Internal Wall	2	1.87	
Soft Holder		Total	2.00			0.98	3.6652
Towel Holder		Total	1.00			1.54	
Mirror		Total	2.00			0.98	1.51
Dryer		Total	1.00			Deduction	
Light Fixtures		Total	3.00			1.00	
Shelve		Total	1.00			0.61	
Door Handrail		Total	1.00			0.82	
Paint						0.98	1.41
						Total	3.76
Metal partition frame b/n the toilet seat	2	1.74		External Wall		1.69	
		0.7	2.44			2.34	3.95
	2	1.74				Deduction	
		0.3	1.044			0.82	
	2	1.63				2.10	1.72
		0.7	2.282			Total	2.23
	2	1.63		Internal Ceiling		1.87	
		0.3	0.978			1.54	2.8798
	4	2.1	5.88			Total	2.88
		0.7					
	4	2.1		Soap Holder		Total	1.00
		0.3	2.52	Soft Holder		Total	1.00
	4	0.73		Towel Holder		Total	1.00
		0.3	0.876	Light Fixtures		Total	2.00
	4	0.73					

Description	Times	Dimensions	Sum	Description	Times	Dimensions	Sum
	2	0.3	0.876	Kitchen 1			
		1.9		Paint			
	2	0.3	1.14	Internal Wall		3.95	
		1.9				2.61	10.31
		0.3	1.14			0.16	
		Total	19.17			2.61	2.77
Women's Toilet 2						0.41	
Paint						2.61	1.06
Internal Wall	2	1.87				3.88	
		0.98	3.6652			0.98	3.80
		1.77				0.14	
		0.98	1.73			2.61	0.37
		Deduction				1.12	
		1.00				2.61	2.92
		0.61				0.33	
		0.82				3.88	1.28
		0.98	1.41			Total	22.51
		Total	3.99	Ceramic			
External Wall		1.87		Floor Tiles		Total	17.17
		2.34	4.38	Wall Tiles		0.6	
		Deduction				3.95	2.37
		0.82				Total	2.37
				Demolish the Partition			
		2.10	1.72	Wall		2.41	
		Total	2.65			2.61	6.29
Internal Ceiling		1.87				1.92	
		1.77	3.3099			0.53	1.02
		Total	3.31			Total	7.31
				Construct Gypsum			
				Board Wall		3.94	
Soap Holder		Total	1.00			2.61	10.28
Soft Holder		Total	1.00			Total	10.28
Towel Holder		Total	1.00	Light Lamp		Total	8.00
Light Fixtures		Total	2.00				
Kitchen 2				Cabinet		Total	1.00
Plastering for Ceiling				Corridor 2			
Internal Ceiling		2.78		Paint			
		2.8	5.58	Internal Wall		1.66	
		Total	5.58			2.54	4.2164
Paint						1.97	
Internal Wall	2	2.78				2.54	5.0038
		2.10	11.676			3.51	
	2	2.80				2.54	8.9154
		2.10	11.76			0.2	
		Deduction				2.54	0.508
		0.75				0.78	
		2.10	1.575			2.54	1.9812
		1.06				Total	20.62
		0.96	1.0176	External Wall		5.22	
		Total	20.84			2.49	12.9978
External Wall		3.23				Deduction	
		2.10	6.783		2	1.00	
		3.00				0.61	1.22
		2.10	6.30			Total	11.78
		1.50		Internal Ceiling		Total	7.34

Page 5

Description	Times	Dimensions	Sum	Description	Times	Dimensions	Sum
		1.08					
		2.41	2.60				
		2.02					
		2.41	4.87				
		0.45					
		2.02	0.91				
		0.37					
		2.41	0.89				
		2.67					
		2.61	6.97				
	2	0.47					
		2.61	2.45				
		0.45					
		2.61	1.17				
		Deduction					
		0.88					
		2.1	1.85				
	2	1.14					
		0.94	2.14				
		0.86					
		2.1	1.81				
	2	0.9					
		2.1	3.78				
		Total	71.58				
PVC Tiles							
Floor Tiles		Total	43.66				
Light Lamp		Total	20.00				
Modifications of							
Partition Windows		Total	2.00				

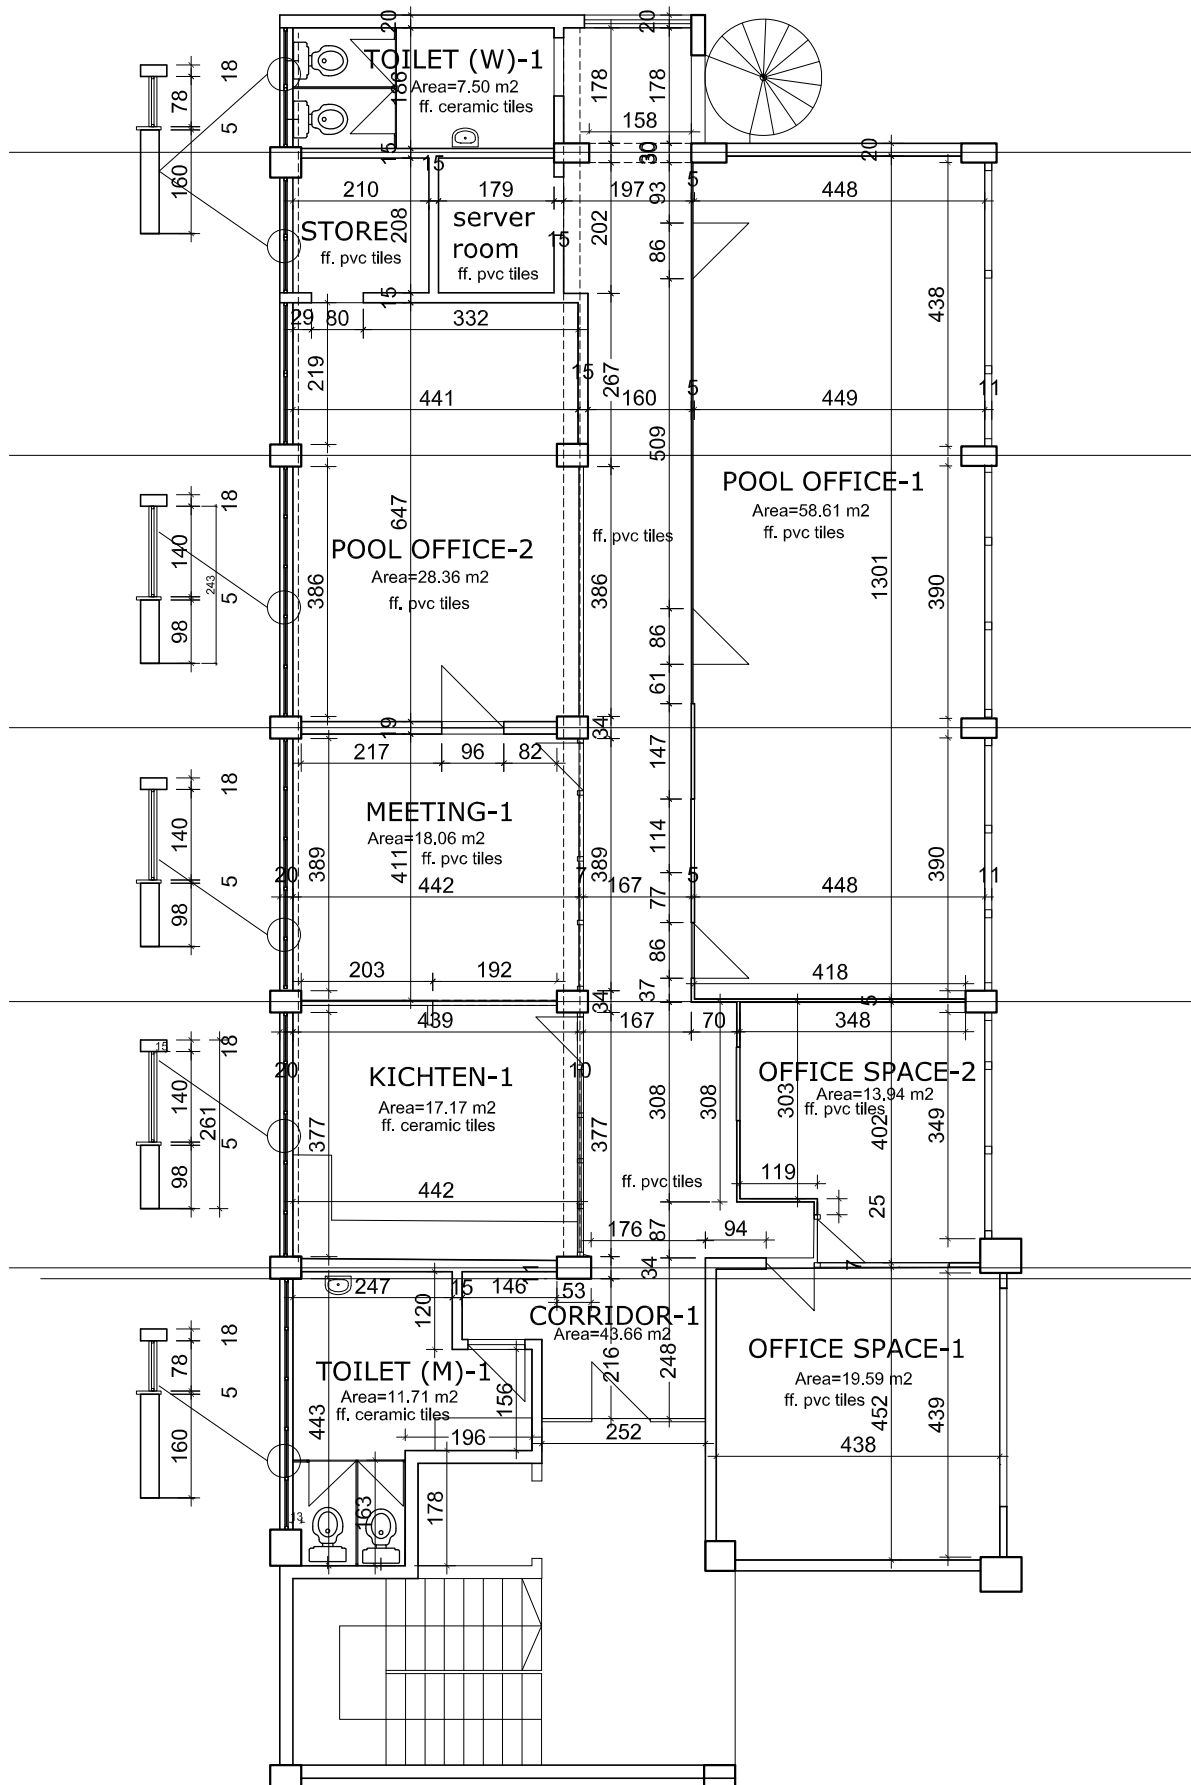


UNITED NATION DEVELOPMENT PROGRAM (UNDP)

OFFICE SPACE RENOVATION






DRAWING TITLE
AS BUILT DRAWING

DATE
DECEMBER. 2019

DRG No
DR 01

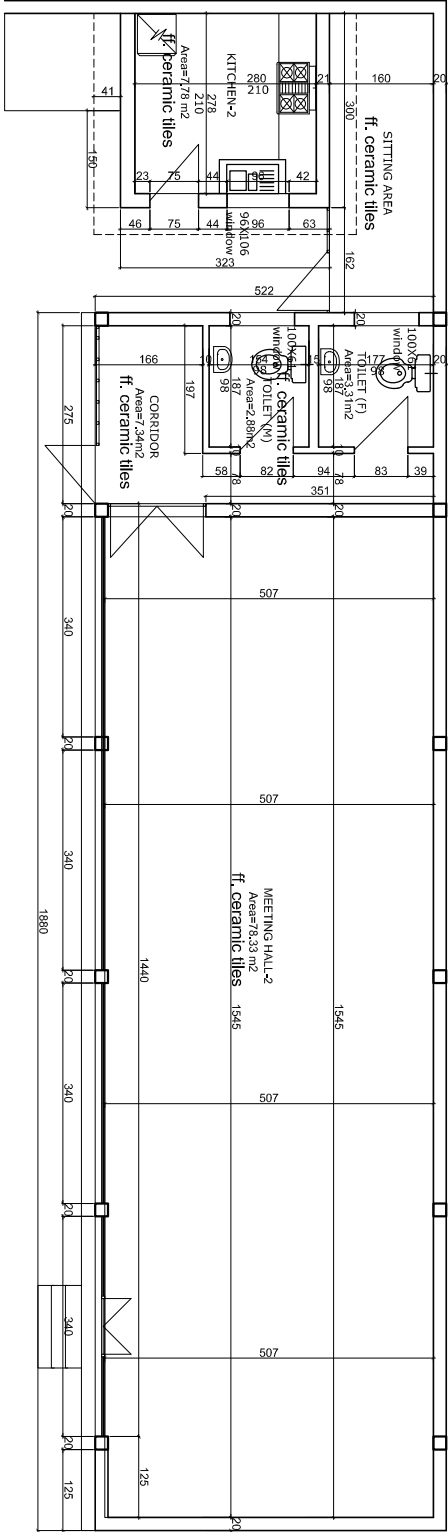

MEETING ROOM

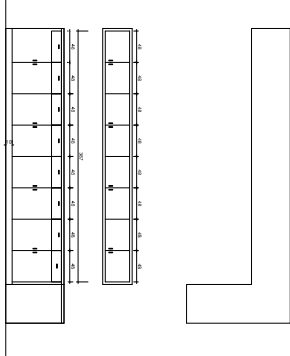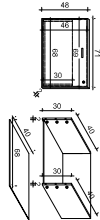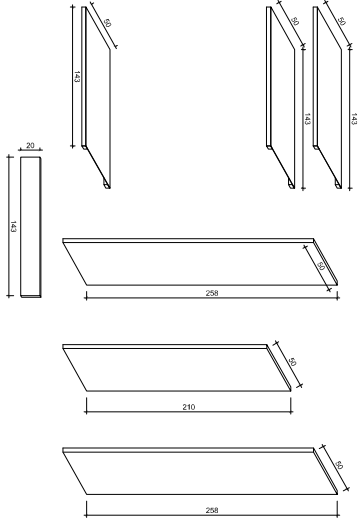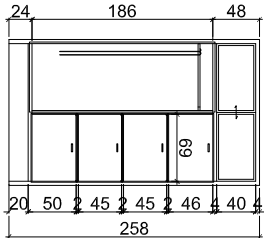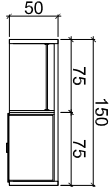

KITCHEN CABINET

UNITED NATION DEVELOPMENT PROGRAM (UNDP)

OFFICE SPACE RENOVATION

DRAWING TITLE
AS BUILT DRAWING

DATE
DECEMBER, 2019

DRG No
DR 02