


General Notes
 Use only figured dimensions.
 All drawings to be checked before putting work in hand.
 Any discrepancies to be reported to the Consultants.
 All work to conform to local building regulations and relevant SANS codes of practice.
 Read in conjunction with latest revision of all drawings, schedules and specification.

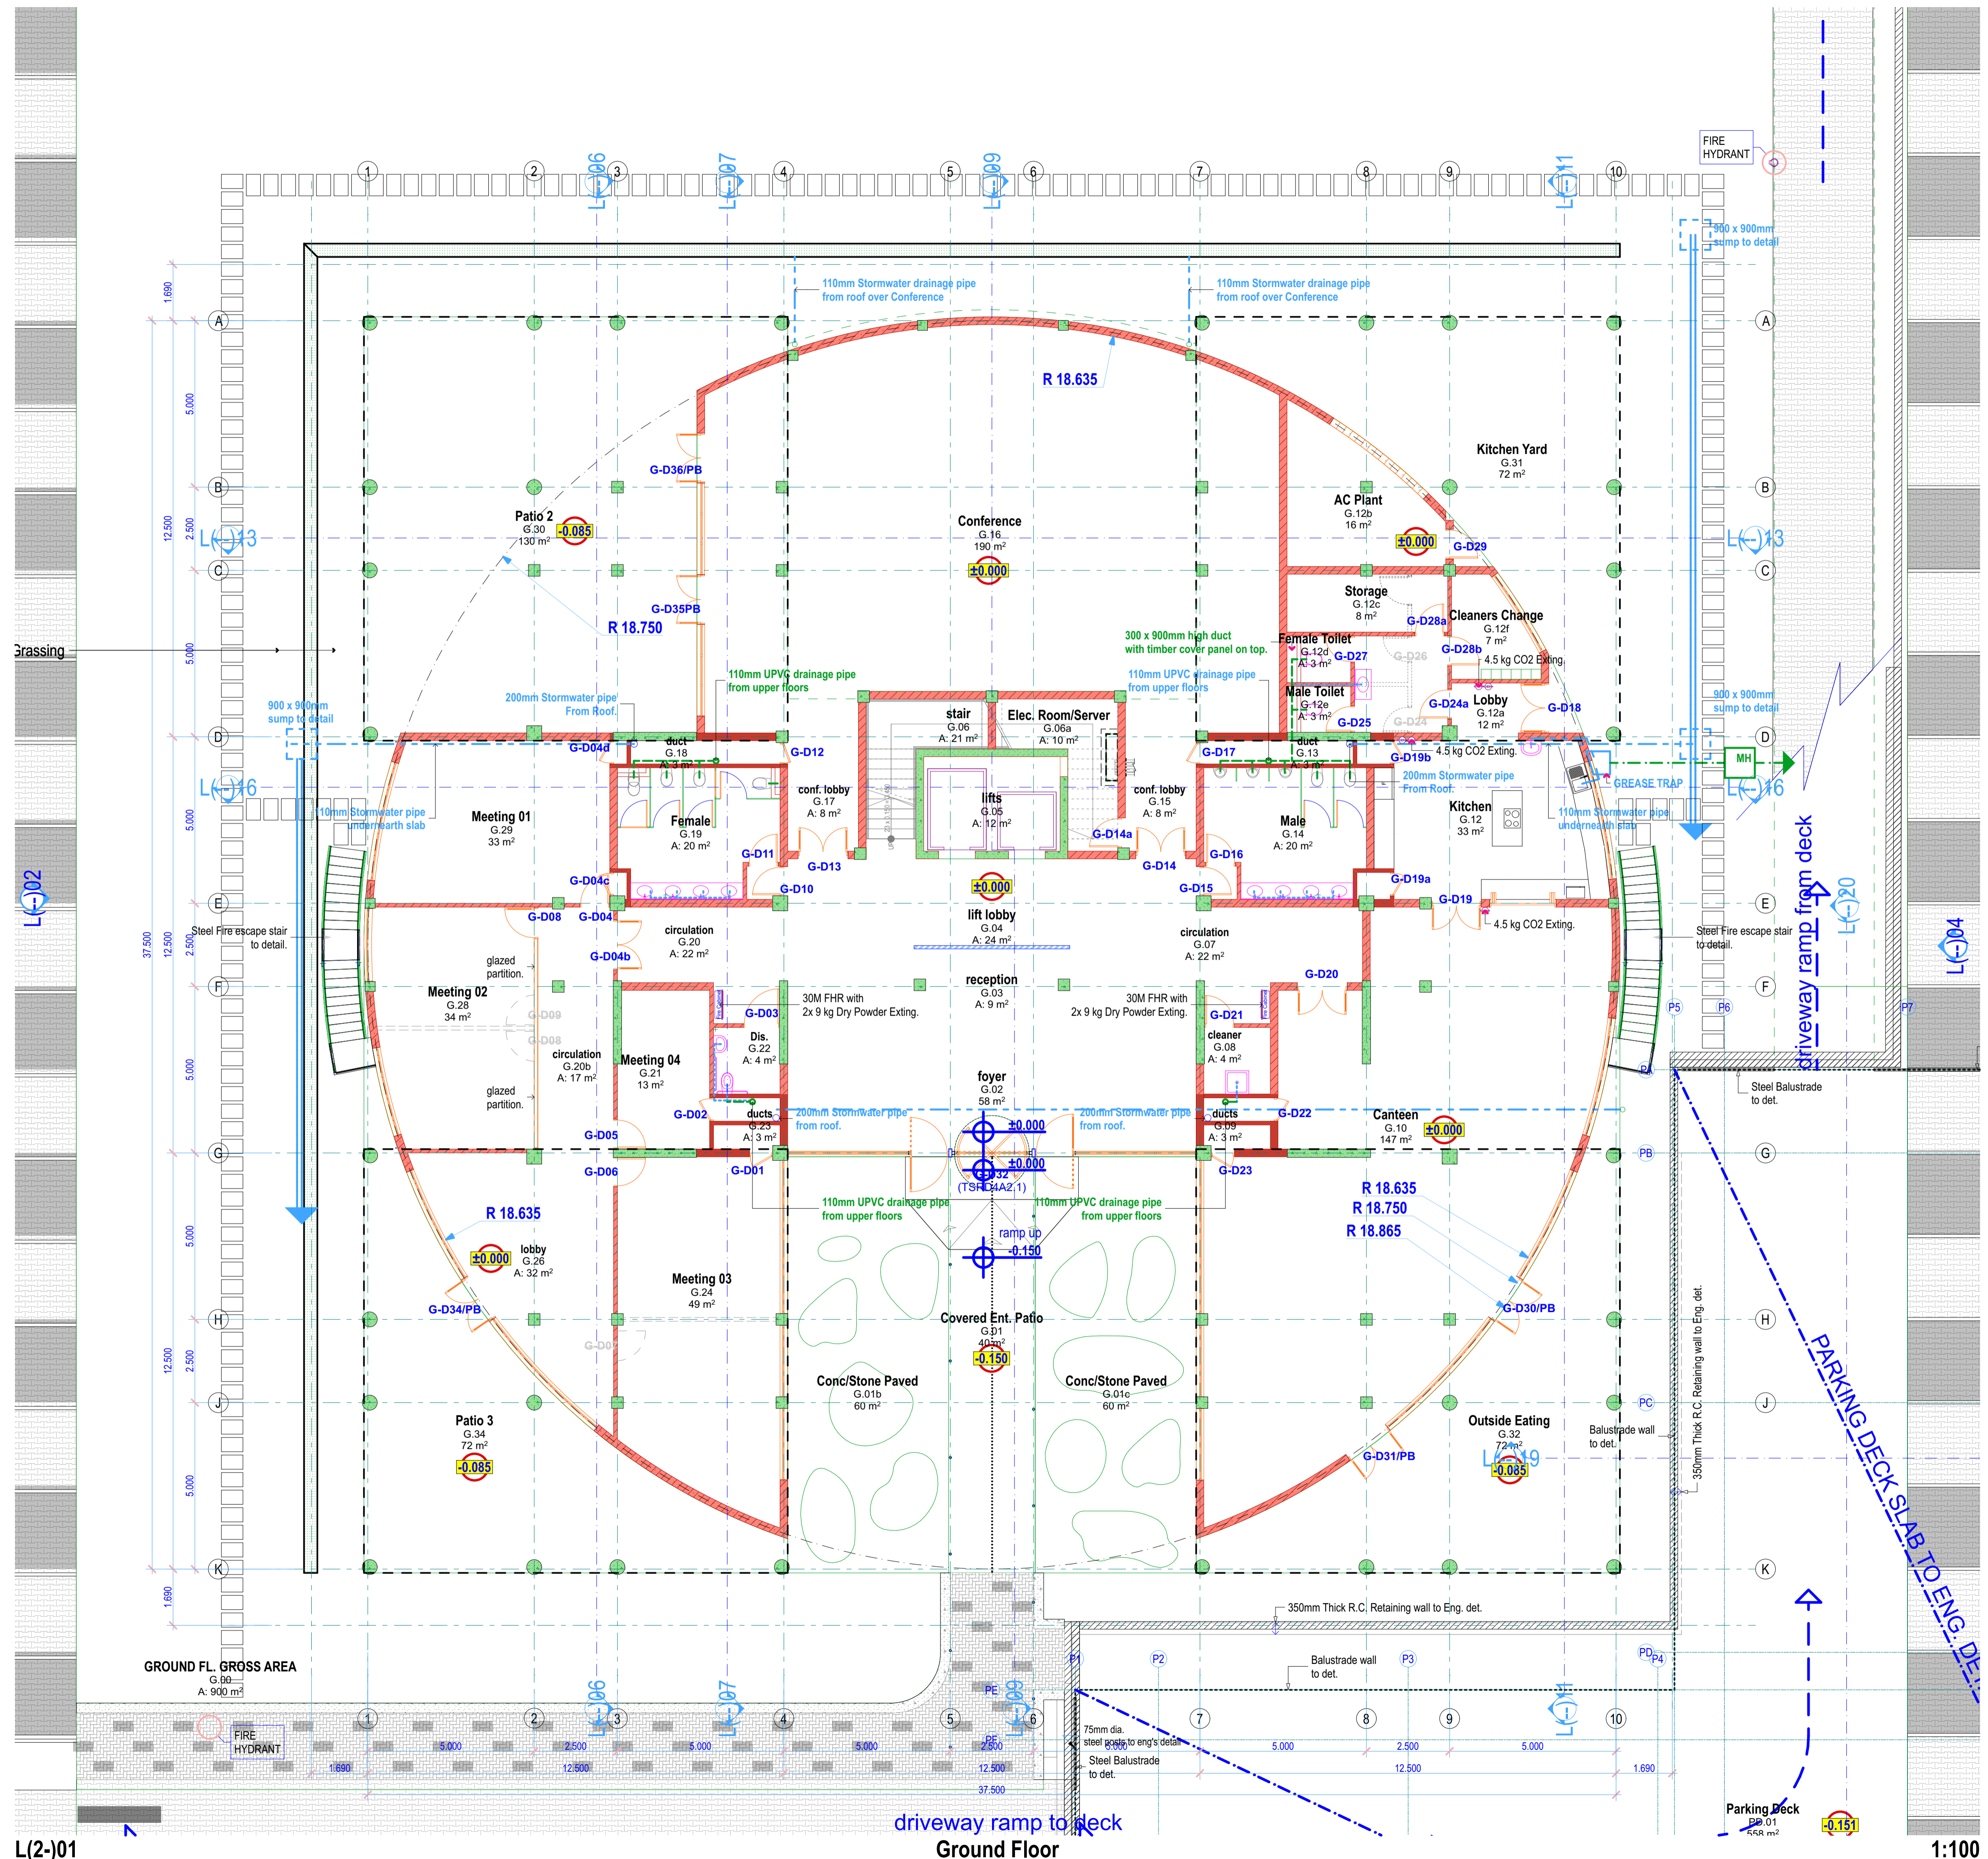

ISSUED TO PM	6A	26.03.19
Revision		Code Date

Headquarters SPV

Owner: ...
 Contact Details:
 Tel: ...
 Email: ...
 Job Title
Proposed UN Office Development
 LOT 3253 (components lot 236, 237, 248 & 249)
 Mbabane
 Swaziland
 Drawing Title
Ground Floor Plan

Steve Hall
 ARCHITECTS AND PLANNERS
 Corner of Mhlabi & Teekwane St. Mbabane, Swaziland
 P.O. Box A790 Swazi Plaza H101, Swaziland
 Tel. +268 404 8515 Fax. +268 404 8513
 email. steve.hall@realnet.co.sz

Copyright notice:
 Copyright © 2018 Steve Hall Development Consultants. Copyright subsists in this drawing. The person or persons who have prepared this drawing shall be deemed to have granted a non-exclusive license to the client to use the drawing for the purposes of the project for which it was prepared. The client shall not be entitled to reproduce or disseminate the drawing or any part thereof without the prior written consent of Steve Hall Development Consultants. All other rights are reserved. Steve Hall Development Consultants is not responsible for any errors or omissions in this drawing. The client shall be responsible for ensuring that the drawing is used in accordance with the relevant building regulations and codes of practice. The client shall be responsible for ensuring that the drawing is used in accordance with the relevant building regulations and codes of practice. The client shall be responsible for ensuring that the drawing is used in accordance with the relevant building regulations and codes of practice.

Purpose of issue	as built	
Project Stage	6: Close Out	
Drawn by	Date	Checked by
AT	dec. 2018	SH
Scale	AS SHOWN	
Project Number	Drawing Number	Status Revision
001	7.6/02	6A