
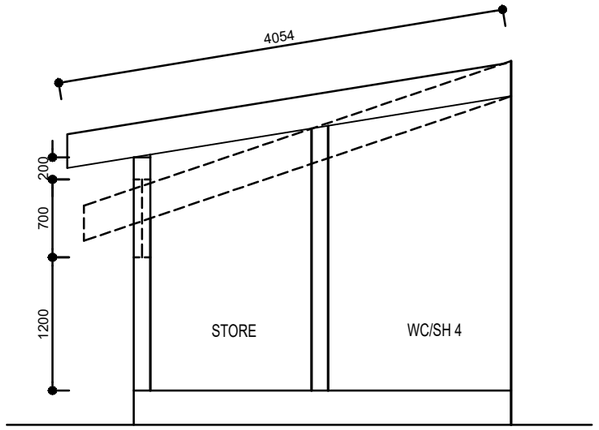


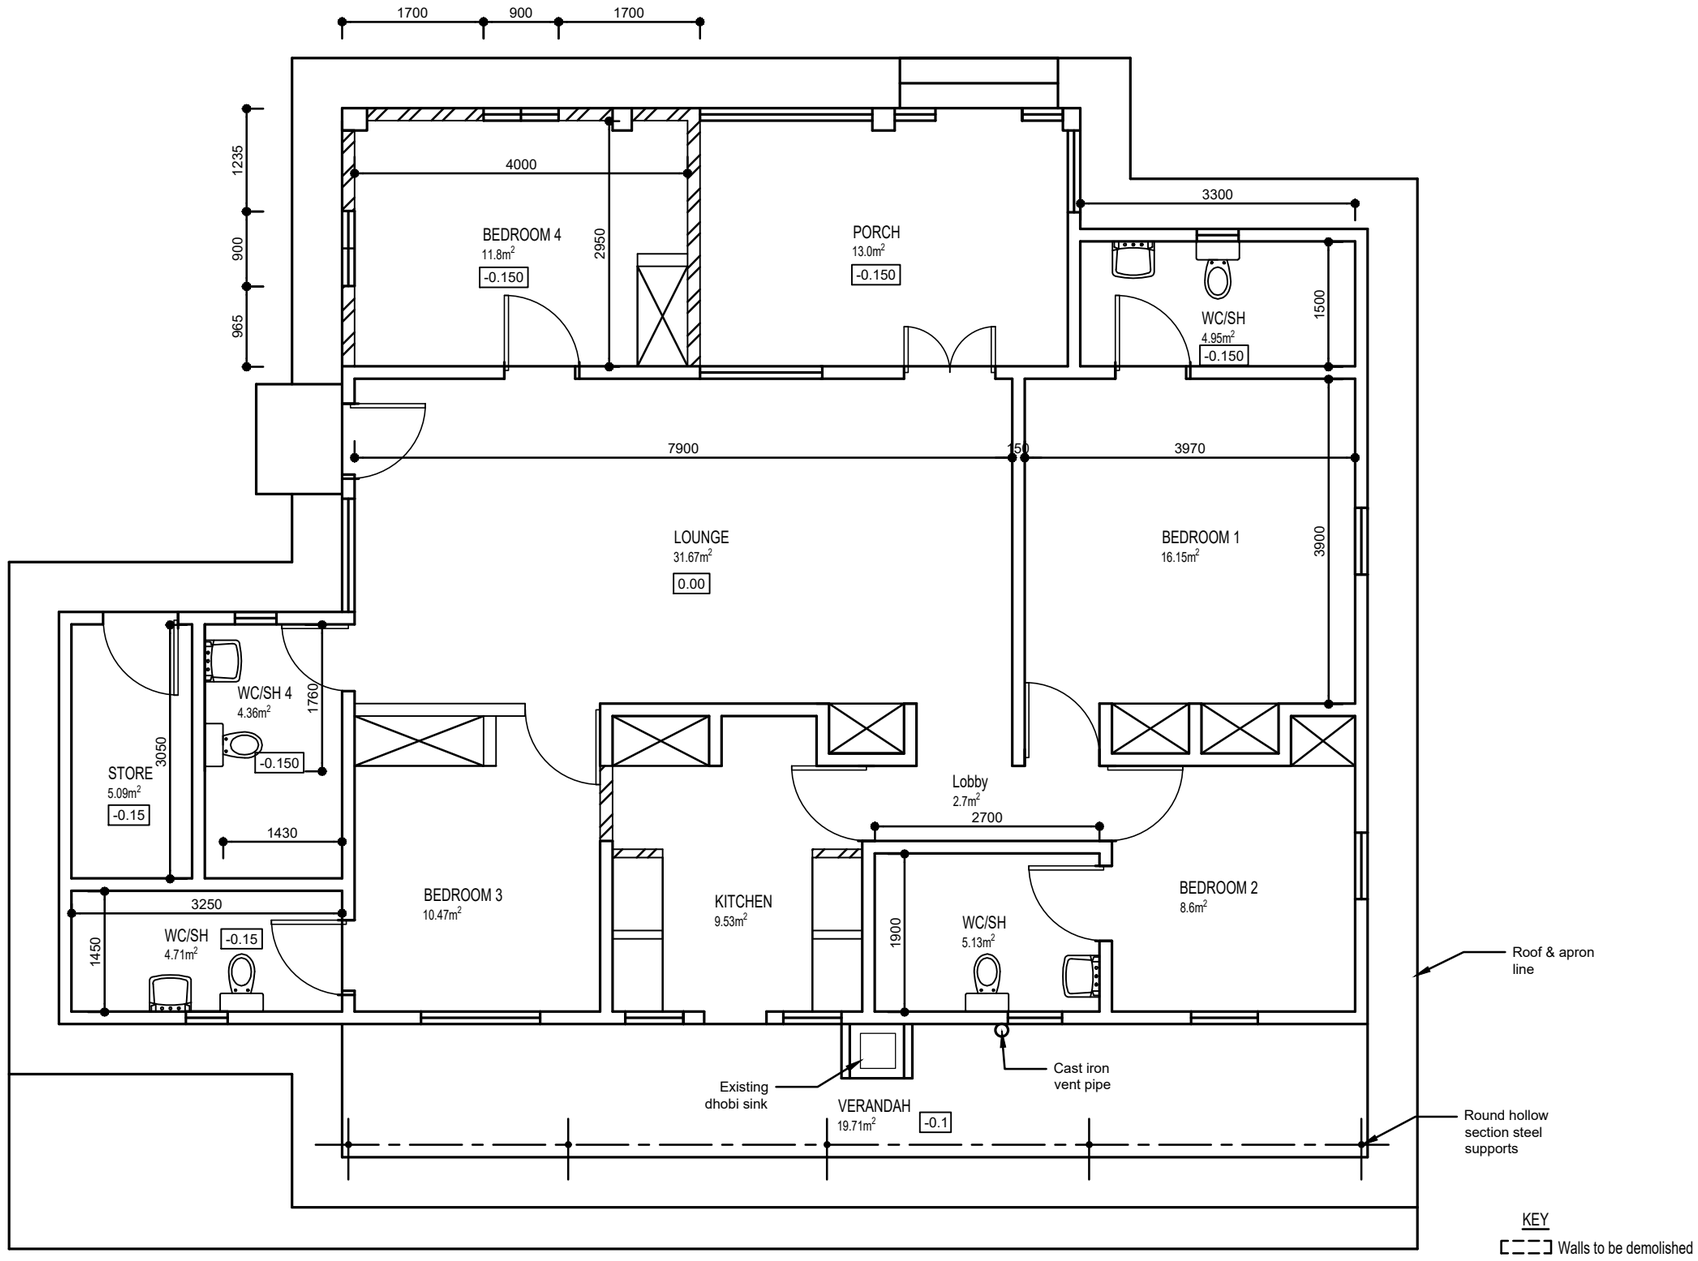

TENDER DRAWING

UNITED NATIONS DEVELOPMENT PROGRAMME **Juba - South Sudan**	**DRAWING TITLE:** Naivasha Residence - Housing Units	**SHEET CONTENT:** As-built foundation Layout Plan	**SCALE:** 1:100, 1:75.		
	DRAWING NAME: Renovation of house 6.dwg		**DATE:** Oct. 2018		
	DESIGN BY: UNDP		**CONTRACT No:**		**DRAWING No:** A-01
	DRAWN BY: Okungulu		**APPROVED FOR IMPLEMENTATION:**		